

5W10639

CODED

PANOLA
P 27
8-29-69

MISSISSIPPI
 BOARD OF WATER COMMISSIONERS
 416 North State Street
 Jackson, Mississippi 39201

CODED

WATER WELL DRILLERS LOG

8-29-69 19 June County Farms Panola
 date well completed firm name county well located

LANDOWNER: M M East

description of formations encountered	from to	
	ft	ft
<u>Clay</u>		<u>27</u>
<u>Sand</u>	<u>27</u>	<u>46</u>
<u>Sand gravel</u>	<u>46</u>	<u>59</u>
<u>Sand</u>	<u>59</u>	<u>66</u>
<u>Sand gravel</u>	<u>66</u>	<u>105</u>

Batesville Miss

(mailing address)

WELL LOCATION:

sec. 15 T. 9 N. R. 28 E.
2 1/2 miles South of Curtis
 (distance) (direction) (nearest town)

WELL PURPOSE: Just Pond
 (home, irrigation, municipal, industrial)

WELL COMPLETION DATA:

- (1) diameter (inches) 16"
- (2) total depth (feet) 105'
- (3) static water level (feet) 10 below above top of ground.
- (4) casing Steel Pipe 57'
 (material) (depth)
16" if telescope see back.
 (size)
- (5) screen 48' 57'
 (length) (depth to top)
16" Double Screen
 (size) (material)
- (6) pump 20 2000
 (HP) (yield gpm)
Chrysler Eng.
 (type power)
- (7) electric log
 (organization running log)
- (8) how well bottom plugged Wellbed



CODED

DRILLERS REMARKS:

SEP 5 1969
 MISSISSIPPI
 WATER BOARD

If well telescopes please sketch and show depths.

GROUND LEVEL

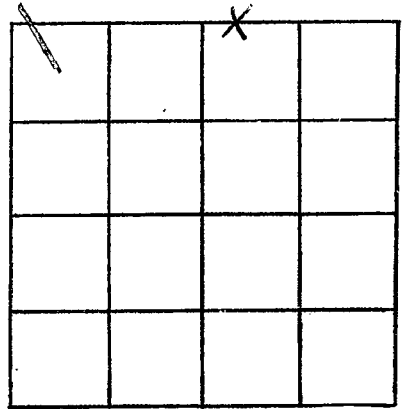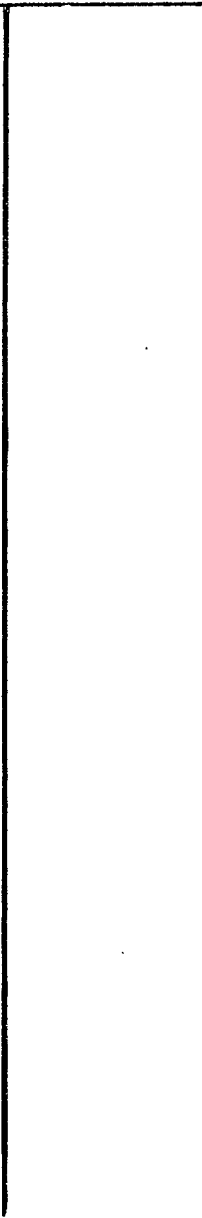

SECTION 15

Please indicate well location X.

ADDITIONAL INFORMATION

Lined area for providing additional information, consisting of multiple horizontal lines.

If more than one screen, show locations of each on sketch.