

PANOLA
P 28
10-15-70

MISSISSIPPI
BOARD OF WATER COMMISSIONERS
416 North State Street
Jackson, Mississippi 39201

CODED

WATER WELL DRILLERS LOG

10-15 date well completed 1970 James R. Lipe firm name Panola county well located

LANDOWNER: Eddie E. Wilson
Courtland Miss.

description of formations encountered	from	to
Clay	0	20
"	20	40
Gravel	40	60
"	60	80
Sand	80	100
"	100	172

(mailing address)

WELL LOCATION:
sec. 38 T 28 N R 2 E
S W
6 miles west of Courtland
(distance) (direction) (nearest town)

WELL PURPOSE: HOME
(home, irrigation, municipal, industrial)

WELL COMPLETION DATA:

- (1) diameter (inches) 4
- (2) total depth (feet) 172
- (3) static water level (feet) 80 below top of ground.
- (4) casing PVC 162
(material) (depth)
If telescope see back.
(size)
- (5) screen 10 162
(length) (depth to top)
4 PVC
(size) (material)
- (6) pump 3/4 10
(HP) (yield gpm)
Elec
(type power)
- (7) electric log NO
(yes or no)
- (organization running log)
- (8) how well bottom plugged PVC
PIUG

CODED


DEC 2 1970

MISS. BD. OF
WATER COMMISSIONERS

DRILLERS REMARKS:

If well telescopes please sketch and show depths.

GROUND LEVEL

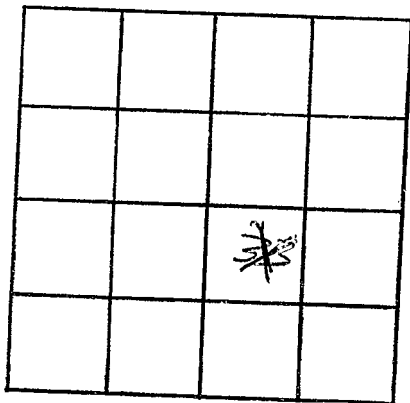

SECTION 3.1

Please indicate well location X.

ADDITIONAL INFORMATION

A series of horizontal lines for writing additional information, starting below the 'ADDITIONAL INFORMATION' header and extending to the bottom of the page.

If more than one screen, show locations of each on sketch.