

Job #7010

County: Panola
 Permit #: _____
 Driller: Pete's Well Drilling
 Date drilling completed: 9-2-07

Well Driller Report and Well Log

Mississippi Department of Environmental Quality
 Office of Land and Water Resources
 P.O. Box 10631
 Jackson, MS 39289-0631
 (601)961-5210
 (601)354-6938 (fax)

For Office Use Only:
 Aquifer: _____
 Well #: P-39
 L. S. Elevation: _____
 E-log #: _____

State Law requires that this report be prepared by the driller in detail and filed with the Department within 30 days of completion of drilling of the well.

Well Owner Information	Well Location
Owner Name: <u>Atkinson Bros.</u>	Latitude: <u>34° 16' 816"</u> Longitude: <u>90° 06' 476"</u>
Mailing Address: 1900 Mgrus Rd <u>1900 Mgrus Rd</u> <u>Baton Rouge, MS 38606</u> City State Zip Code	Method of Lat/Long (circle one): <u>Hand-held GPS</u> Conventional Survey, 28
Telephone No. <u>(662) 444-1120</u>	USGS quad <u>Hand-held GPS</u> , Survey-grade GPS <u>NE 1/4 NE 1/4 Sec 26</u> Twn <u>9S</u> Rng <u>9W</u>
	Distance Direction Nearest Town <u>12</u> Miles <u>E</u> of <u>Marks</u>

Well Data

Purpose of Well (circle one) Home Industrial Public Supply Irrigation Fish Culture Other: _____

Date well drilling started: 9-2-07 Date well drilling completed: 9-2-07

If flowing, method of flow regulation: Valve _____ Other (describe) _____

Static Water Level: 8 feet above or below (circle one) land surface Date measured: 9-2-07

Method of Measurement (circle one) steel tape electric tape air line other: _____

Hole depth: 100 Well depth: 100 Well grouted to a depth of 10 feet

Type of grout (circle one): Cement Bentonite Mix

Casing length: 60 feet Casing diameter: 16 inches Type of casing: PVC

Screen length: 40 feet Screen diameter: 16 inches Type of screen: PVC

Screen slot size: .032 inches Setting depth: From 60 feet to 100 feet

Type of completion (circle all applicable): Gravel packed Underreamed Telescoped Open hole Natural Development

Other (describe): _____

Top of lap pipe or reduction in casing: _____ feet. If telescoped or more than one screen, describe in detail.

Logs run (circle all applicable): No log run Electric Gamma Ray Density Sonic Neutron Other: SEP 18 2007

Name of organization running log(s): _____

I certify that the well was drilled, constructed, and completed in accordance with all applicable requirements of the Mississippi Department of Environmental Quality and/or the Mississippi Department of Health regulations and state laws.

Pete's Well Drilling 0431
 Print Name of Water Well Contractor and License No.

[Signature]
 Signature of Water Well Contractor


RECEIVED
 BY: OLWR

If well telescopes please sketch below and show depths.

No part 2

Ground Level	Description of Formations Encountered	From	To
	Clay	0	10
	Fine Sand	10	28
	Course Sand	28	100

If more than one screen, show location of each on sketch

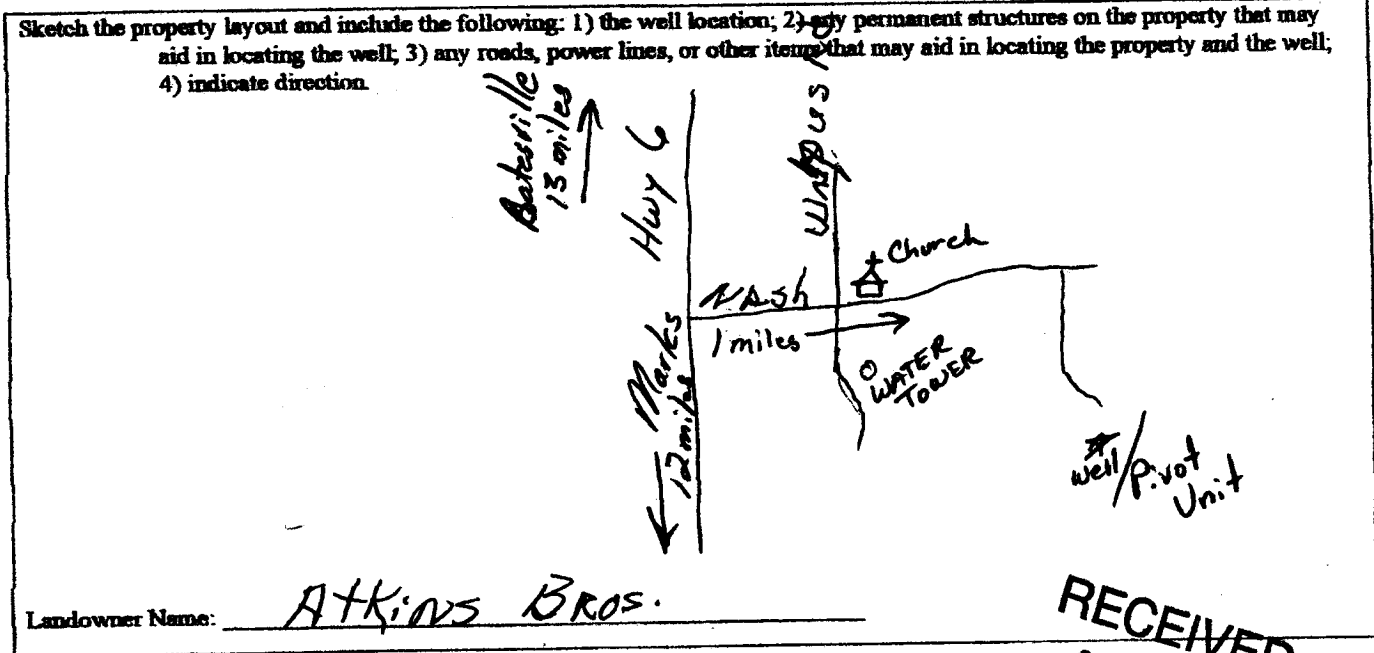

Signature of Water Well Contractor

RECEIVED
SEP 18 2007
BY: OLWR