

Q
9-10-64

WATER WELL DRILLERS LOG

Date: 9-10-1964, Driller: J B Cain County Panola
(Name)

(1) Owner of Land: MR Blue
(Name)
Batumele
(Address)

(2) Location: 1/4, 1/4, Sec. T R R
6 miles W of Batumele
(distance) (direction) (Nearest Town)

(3) Topography: Level
(Hilly) (Flat) (Level)

(4) Purpose of Well:
(Domestic Irrigation
Municipal, Industrial, Other)

Description & Color of Materials Sand, Clay, Red Clay, Shell, etc.	Thick- ness Feet	Depth Feet
<u>Sand</u>	<u>0</u>	<u>180</u>
<u>Blue</u>	<u>180</u>	<u>300</u>
<u>land</u>	<u>300</u>	<u>405</u>

Information upon completion of well:

(1) Diameter 4 inches.

(2) Total Depth 405 feet.

(3) Water Level Flowing feet below top of ground.


(4) Cased to 130, Size 4"

(5) Screen: Size _____, Length _____

(6) Were any formations sealed against pollution?
_____ yes, _____ no.

If YES depth of formation _____
Why _____

Drillers Remarks:
Open Bottom
well

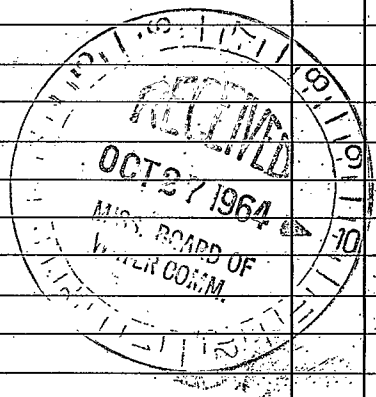

(Use Back Side)

Well No.

1870

1871

1872

1887