

PANOLA

MISSISSIPPI BOARD OF WATER COMMISSIONERS

④ ① 6
4-14-63

WATER WELL DRILLERS LOG

CODED

CODED

Date: 4-14, 1963, Driller: James R. Kripe County Panola
(Name)

(1) Owner of Land: Eurel Toyner
(Name)
Courtland
(Address)

(2) Location: 1/4, 1/4, Sec. 36 T. 9 R. 8
5 W
8 miles S.W. of Batesville
(distance) (direction) (Nearest Town)

(3) Topography: Hilly
(Hilly) (Flat) (Level)

(4) Purpose of Well: Domestic
(Domestic Irrigation
Municipal, Industrial, Other)

Description & Color of Materials Sand, Clay, Red Clay, Shell, etc.	Thick- ness Feet	Depth Feet
<u>Red Clay</u>	<u>0</u>	<u>15</u>
<u>Clay & Sand</u>	<u>15</u>	<u>40</u>
<u>Sandy gravel</u>	<u>40</u>	<u>70</u>
<u>Clay & gravel</u>	<u>70</u>	<u>95</u>
<u>Gravel</u>	<u>95</u>	<u>115</u>
<u>off bearing sand</u>	<u>115</u>	<u>142</u>

Information upon completion of well:

(1) Diameter 2 inches.

(2) Total Depth 142 feet.

(3) Water Level 90 feet below top of ground.

(4) Cased to 135, Size 2"

(5) Screen: Size 1 1/4, Length 6'


(6) Were any formations sealed against pollution?
_____ yes, _____ no.

If YES depth of formation _____

Why _____

Drillers Remarks: _____

CODED

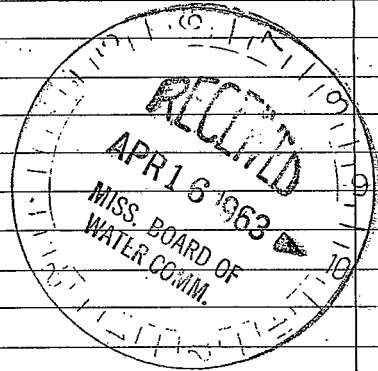

(Use Back Side)

Well No.

