

PANOLA MISSISSIPPI BOARD OF WATER COMMISSIONERS

R 9 8

6-10-66

James Ray Lipe
WATER WELL DRILLERS LOG

CODED

Date: 6.10, 1966, Driller: Frank Lipe county Panola
(Name)

(1) Owner of Land: Hardin Williams
(Name)

Batesville Miss,
(Address)

(2) Location: 1/4, 1/4, Sec. 36 9 3 T. 3 R 5 E
5 miles S.W. of Batesville
(distance) (direction) (Nearest Town)

(3) Topography: Hilly
(Hilly) (Flat) (Level)

(4) Purpose of Well: Domestic
(Domestic Irrigation
Municipal, Industrial, Other)

Description & Color of Materials
Sand, Clay, Red Clay, Shell, etc.

Thick-
ness
Feet

Depth
Feet

Clay	0	20
red sand	20	40
" "	40	60
" "	60	80
Gravel	80	100
"	100	120
pea gravel	120	140
water sand	140	157

Information upon completion of well:

(1) Diameter 2 inches.

(2) Total Depth 157 feet.

(3) Water Level 140 feet below top of ground.

(4) Cased to 147, Size 2 1/4

(5) Screen: Size 1 1/4, Length 6'


(6) Were any formations sealed against pollution?

_____ yes, _____ no.

If YES depth of formation _____

Why _____

Drillers Remarks: _____

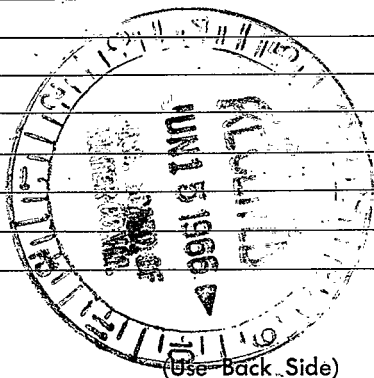

(Use Back Side)

Well No. _____

