

Panola
Q 10
7-14-69

MISSISSIPPI
 BOARD OF WATER COMMISSIONERS
 416 North State Street
 Jackson, Mississippi 39201

WATER WELL DRILLERS LOG

7.14 1969 James A. Lipe Panola
 date well completed firm name county well located

LANDOWNER: V. S. Shuford
Batesville Miss.
 (mailing address)

WELL LOCATION:
 sec. 27 T. 9 N R. 8
6 miles West of Batesville
 (distance) (direction) (nearest town)

WELL PURPOSE: home
 (home, irrigation, municipal, industrial)

WELL COMPLETION DATA:

- (1) diameter (inches) 4"
- (2) total depth (feet) 158
- (3) static water level (feet) 100 below above top of ground.
- (4) casing plastic 150
 (material) (depth)
4 if telescope see back.
 (size)
- (5) screen 8 150
 (length) (depth to top)
4 plastic
 (size) (material)
- (6) pump 3/4 10
 (HP) (yield gpm)
Elec.
 (type power)
- (7) electric log no
 (yes or no)
no
 (organization running log)
- (8) how well bottom plugged with plastic plug

description of formations encountered	from	to
<u>Clay</u>	<u>0</u>	<u>90</u>
<u>Clay</u>	<u>90</u>	<u>40</u>
<u>red sand</u>	<u>40</u>	<u>60</u>
<u>Gravel</u>	<u>60</u>	<u>80</u>
<u>Standard clay</u>	<u>80</u>	<u>100</u>
<u>sand</u>	<u>100</u>	<u>140</u>
<u>II</u>	<u>140</u>	<u>158</u>


DRILLERS REMARKS:

OCT 20 1969

MISS. BD. OF
 WATER CONTROL

If well telescopes please sketch and show depths.

GROUND LEVEL

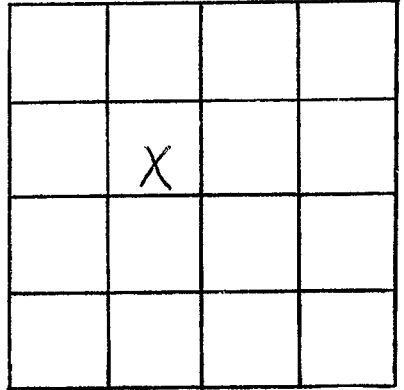

SECTION 27

Please indicate well location X.

ADDITIONAL INFORMATION

If more than one screen, show locations of each on sketch.