

GW1994

m

MISSISSIPPI
BOARD OF WATER COMMISSIONERS
416 North State Street
Jackson, Mississippi 39201

CODED

WATER WELL DRILLERS LOG

PANOLA
Q 13
1-21-70

Jan. 21, 19 70 Layne-Central Company Panola
date well completed firm name county well located

LANDOWNER:
Tennessee Gas Pipeline Co.
Batesville, Mississippi
(mailing address)

WELL LOCATION:
sec 19 T. 9 S. R. 8 W.
7 miles W of Batesville
(distance) (direction) (nearest town)

WELL PURPOSE: Gas pipe line
(home, irrigation, municipal, industrial)

WELL COMPLETION DATA:

(1) diameter (inches) 12"
(2) total depth (feet) 1046'
(3) static water level (feet) 5' ~~xxxx~~ above top of ground.
(4) casing steel, 1000' (material), (depth), 12" (size) if telescope see back.
(5) screen 40' (length), 1006' (depth to top), 8" (size), s.s. shutter (material)
(6) pump 10 (HP), 200 (yield gpm), electric (type power)
(7) electric log (yes or no)
(organization running log)
(8) how well bottom plugged

description of formations encountered	from	to
Clay	15	15
Sand and gravel	76	51
Clay	104	28
Rock	105	1
Clay	176	71
Rock	178	2
Clay	184	6
Rocks and clay	200	16
Clay	273	73
Rocks and clay	290	17
Clay	330	40
Sand and clay	385	55
Clay	396	11
Rock	398	2
Hard shale	420	22
Sandy shale	520	100
Sand	612	92
Sandy shale	642	30
Shale	863	221
Rock	865	2
Shale	885	20
Rock	886	1
Shale	969	83
Rock	972	3
Hard shale	1000	28
Sandy shale	1020	20
Sand	1046	26
Shale	1097	51
Sand & shale sts.	1127	30
Shale & sand sts.	1161	34
Rock	1162	1
Shale & rock	1164	2
Shale	1200	36



DRILLERS REMARKS:

FEB 6 - 1970

MISS. BD. OF WATER COMM.

If well telescopes please sketch and show depths.

GROUND LEVEL

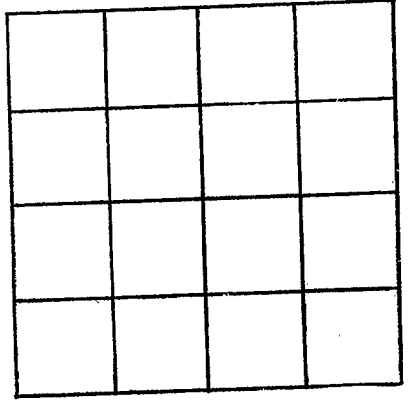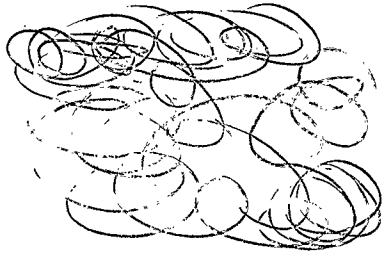

SECTION _____

Please indicate well location X.

ADDITIONAL INFORMATION

If more than one screen,
show locations of each on sketch.