

Panola

Q 14

2-9-70

MISSISSIPPI
 BOARD OF WATER COMMISSIONERS
 416 North State Street
 Jackson, Mississippi 39201

CODED

WATER WELL DRILLERS LOG

2-9 1970 LIPE WELLS, PANOLA
 date well completed firm name county well located

LANDOWNER:

Ben Ed Roberson

Courtland, Miss
 (mailing address)

WELL LOCATION:

sec 27-T-9 N R 8 E
 7 miles SW of Batesville
 (distance) (direction) (nearest town)

WELL PURPOSE: home
 (home, irrigation, municipal, industrial)

WELL COMPLETION DATA:

- (1) diameter (inches) 4"
- (2) total depth (feet) 164'
- (3) static water level (feet) 80' (below top of ground)
- (4) casing PVC 156' (material) (depth)
 4" (size) If telescope see back.
- (5) screen 8' 156' (length) (depth to top)
 4" PVC + silica (size) (material)
- (6) pump 3/4 10 (HP) (yield gpm)
 elec (type power)
- (7) electric log no (yes or no)
 (organization running log)
- (8) how well bottom plugged PVC cap

description of formations encountered

from to

deep sand + clay	0	20
sand + gravel	20	40
sand + gravel	40	60
sand + gravel	60	80
clay	80	100
sand	100	120
sand	120	140
sand	140	164

CODED


MAR 5 - 1970

MISS. BD. OF WATER COMM.

DRILLERS REMARKS:

If well telescopes please sketch and show depths.

GROUND LEVEL

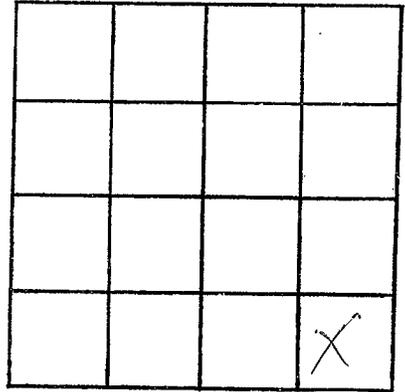

SECTION 27

Please indicate well location X.

ADDITIONAL INFORMATION

If more than one screen,
show locations of each on sketch.