

PANOLA

WATER WELL DRILLERS LOG

Date 5-1-63, 1963, Driller: James B. Speer County Panola
(Name)

CODED

(1) Owner of Land: Alvin Shupard
(Name)
Batesville
(Address)

(2) Location: 1/4, 1/4, Sec 34 T. 8 N. R. 8 W.
6 miles West of Batesville
(distance) (direction) (Nearest Town)

(3) Topography: Hilly
(Hilly) (Flat) (Level)

(4) Purpose of Well: Domestic
(Domestic Irrigation
Municipal, Industrial, Other)

Description & Color of Formation Sand, Clay, Red Clay, Shell, etc.	Thickness Feet	Depth Feet
<u>Clay & Sand</u>	<u>0</u>	<u>20</u>
<u>Gravel</u>	<u>20</u>	<u>35</u>
<u>Gravel & Sand</u>	<u>35</u>	<u>35</u>
<u>Clearing Sand</u>	<u>55</u>	<u>70</u>

Information upon completion of well:

(1) Diameter 2 inches.

(2) Total Depth 70' feet.

(3) Water Level 40' feet below top of ground.

(4) Cased to 02', Size 2"

(5) Screen: Size 1 1/4", Length 6'

(6) Were any formations sealed against pollution?
_____ yes, _____ no.


??
JES
5-20-69
8

CODED

If YES depth of formation _____

Why _____

Drillers Remarks: _____

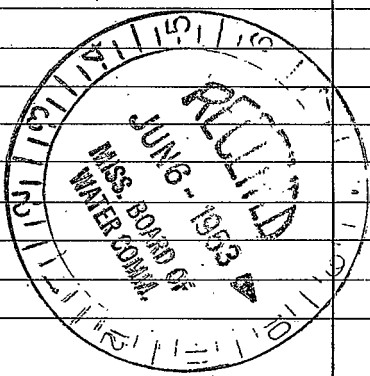

(Use Back Side)

Well No.

