

Panola  
Q19  
1-67

MISSISSIPPI  
BOARD OF WATER COMMISSIONERS  
416 North State Street  
Jackson, Mississippi 39201

**CODED**

WATER WELL DRILLERS LOG

1-15 1967 Roberson & Son Panola  
date well completed firm name county well located

LANDOWNER: J.R. Major

description of formations encountered

from to

Pt 1

Batesville, Miss  
(mailing address)

Clay & Red Sand	0	20
White Clay	20	60
White Sand & Pea gravel	60	90

WELL LOCATION:

sec. 12 T~~1~~N R. 8 E  
9 S W  
4 miles W of Batesville  
(distance) (direction) (nearest town)

WELL PURPOSE: Trailer Park  
(home, irrigation, municipal, industrial)

WELL COMPLETION DATA:

(1) diameter (inches) 4 in  
(2) total depth (feet) 90 ft  
(3) static water level (feet) 15 below above top of ground.

(4) casing Plastic, 85 ft  
(material) (depth)

4 in if telescope see back.  
(size)

(5) screen 5 ft, 85 ft  
(length) (depth to top)

6 in, gravel packed  
(size) (material)

(6) pump 1 30  
(HP) (yield gpm)

TVA 220  
(type power)

(7) electric log no  
(yes or no)


(organization running log)

(8) how well bottom plugged whole  
bottom

DRILLERS REMARKS: Plastic

water well

**CODED**

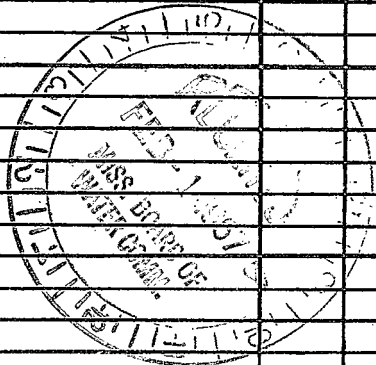

If well telescopes please sketch and show depths.

GROUND LEVEL

	X		

SECTION 13

Please indicate well location X.

ADDITIONAL INFORMATION

If more than one screen, show locations of each on sketch.