

MISSISSIPPI
BOARD OF WATER COMMISSIONERS
416 North State Street
Jackson, Mississippi 39201

CODED

WATER WELL DRILLERS LOG

Panola
Q 22
5-68

May 4 19*68* *Roberson & Son* *Panola*
date well completed firm name county well located

LANDOWNER: *Frank Tucker*
Batesville, Miss
(mailing address)
WELL LOCATION:
sec. *33* T. *28* N. R. *2* E.
7 miles *SW* of *B. Vile*
(distance) (direction) (nearest town)
WELL PURPOSE: *Home*
(home, irrigation, municipal, industrial)

description of formations encountered	from	to
<i>Red Clay</i>	<i>0</i>	<i>20</i>
<i>sand & clay</i>	<i>20</i>	<i>40</i>
<i>gravel & sand</i>	<i>40</i>	<i>60</i>
<i>gravel</i>	<i>60</i>	<i>80</i>
<i>gravel & sand</i>	<i>80</i>	<i>100</i>
<i>sand</i>	<i>100</i>	<i>180</i>

WELL COMPLETION DATA:
(1) diameter (inches) *4"*
(2) total depth (feet) *180*
(3) static water level (feet) *120* below above top of ground.
(4) casing *plastic*, *175'*
(material) (depth)
4" If telescope see back.
(size)
(5) screen *5-ft*, *175-ft*
(length) (depth to top)
4", *gravel packed*
(size) (material)
(6) pump *34* *10*
(HP) (yield gpm)
EVA-220
(type power)
(7) electric log *yes*
(yes or no)
(organization running log)
(8) how well bottom plugged *cased*


CODED

JUL 26 1968
M. D. BOARD OF

DRILLERS REMARKS: *Plastic water well*

If well telescopes please sketch and show depths.

GROUND LEVEL

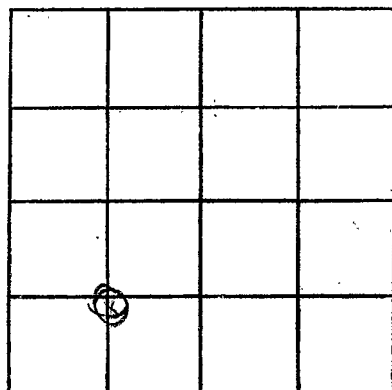

SECTION 53

Please indicate well location X.

ADDITIONAL INFORMATION

If more than one screen, show locations of each on sketch.