

Panola
Q23
8-23-68

MISSISSIPPI
 BOARD OF WATER COMMISSIONERS
 416 North State Street
 Jackson, Mississippi 39201

CODED

WATER WELL DRILLERS LOG

Aug 23 1968 Robinson Panola
 date well completed firm name county well located

LANDOWNER: Dwight Boyles
Bateville, Miss
 (mailing address)

description of formations encountered	from	to


WELL LOCATION:
 sec. 33 T. 9 R. 8
7 1/2 miles SW of Bateville
 (distance) (direction) (nearest town)

<u>Red clay</u>	<u>0</u>	<u>40</u>
<u>sand + gravel</u>	<u>40</u>	<u>80</u>
<u>Blue clay</u>	<u>80</u>	<u>140</u>
<u>white sand</u>	<u>140</u>	<u>180</u>

WELL PURPOSE: home
 (home, irrigation, municipal, industrial)

- WELL COMPLETION DATA:
- (1) diameter (inches) 4"
 - (2) total depth (feet) 180
 - (3) static water level (feet) 140 below above top of ground.
 - (4) casing plastic, 175
 (material) (depth)
 - 4 If telescope see back.
 (size)
 - (5) screen 5 ft, 175
 (length) (depth to top)
 - 4, gravel packed
 (size) (material)
 - (6) pump 3/4 10
 (HP) (yield gpm)
 - 2WA 220
 (type power)
 - (7) electric log no
 (yes or no)
 - (organization running log)
 - (8) how well bottom plugged capd

CODED

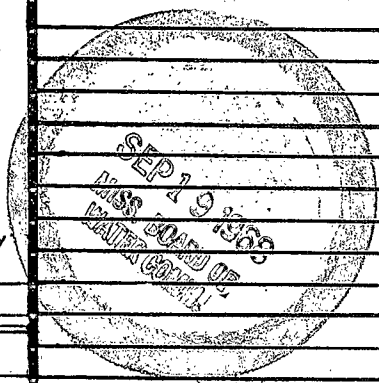

DRILLERS REMARKS: Plastic
seal well

If well telescopes please sketch and show depths.

GROUND LEVEL

X			

SECTION 3.3

Please indicate well location X.

ADDITIONAL INFORMATION

If more than one screen, show locations of each on sketch.