

LOCATION

PANOLA
Q 24
5-24-73

MISSISSIPPI
BOARD OF WATER COMMISSIONERS
416 North State Street
Jackson, Mississippi 39201

CODED

WATER WELL DRILLERS LOG

5-24 1973 James R. Lipe Panola
date well completed firm name county well located

LANDOWNER:	description of formations encountered	from	to
Gin on no 6 Hwy. Batesville Miss. (mailing address)	red clay " " " clay and sand sand	0 20 40 60	20 40 60 74
WELL LOCATION: sec. 14 T 9 N R 2 E W 3 miles west of Batesville (distance) (direction) (nearest town)			
WELL PURPOSE: (home, irrigation, municipal, industrial)			
WELL COMPLETION DATA:			
(1) diameter (inches) 4			
(2) total depth (feet) 94			
(3) static water level (feet) 22 below top of ground.			
(4) casing PVC 84 (material) (depth) 4 (size) if telescope see back.			
(5) screen 10 84 (length) (depth to top) 4 PVC (size) (material)			
(6) pump 1 1/2 30 (HP) (yield gpm) Elec. (type power)			
(7) electric log No (yes or no) No (organization running log)			
(8) how well bottom plugged PVC plug			
DRILLERS REMARKS:			


CODED

DATE 7 1973

Misc. D.
WATER BOARD

If well telescopes please sketch and show depths.

GROUND LEVEL

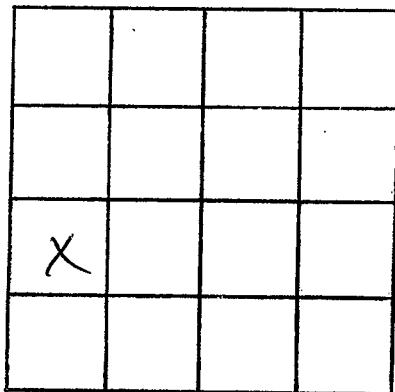

SECTION 14

Please indicate well location X.

ADDITIONAL INFORMATION

Lined area for additional information.

If more than one screen, show locations of each on sketch.