

PANOLA
Q 25
9-5-73

MISSISSIPPI
BOARD OF WATER COMMISSIONERS
416 North State Street
Jackson, Mississippi 39201

CODED

WATER WELL DRILLERS LOG

9-5-1973 date well completed
James R. Live firm name
Panola county well located

LANDOWNER:

Earl Stamps
Batesville Miss.
(mailing address)

description of formations encountered

from	to
0	20
20	40
40	60
60	80
80	100
100	120
120	140
140	160
160	180

Top soil
Clay
Sand and subgrade
Sand
Clay and sand
" " " "
Sand
" "

WELL LOCATION:

sec. 26 T 9 N R 8 E
4 miles N.W. of Batesville
(distance) (direction) (nearest town)

WELL PURPOSE:

(home) Irrigation, municipal, industrial

WELL COMPLETION DATA:


- (1) diameter (inches) 4
- (2) total depth (feet) 180
- (3) static water level (feet) 100 below top of ground.
- (4) casing PVC, 170 (material), (depth), 4 (size) if telescope see back.
- (5) screen 10, 170 (length), (depth to top), 4, PVC (size), (material)
- (6) pump 3/4, 10 (HP), (yield gpm), elec (type power)
- (7) electric log NO (yes or no), NO (organization running log)
- (8) how well bottom plugged PVC CAP

CODED

DRILLERS REMARKS:

If well telescopes please sketch and show depths.

GROUND LEVEL

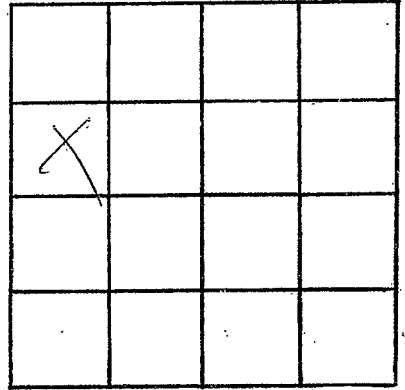

SECTION 26

Please indicate well location X.

ADDITIONAL INFORMATION

If more than one screen,
show locations of each on sketch.