

MISSISSIPPI
BOARD OF WATER COMMISSIONERS
416 North State Street
Jackson, Mississippi 39201

CODED

WATER WELL DRILLERS LOG

Panna
Q 26
7-30-75

9-30 1975 LiPe well Co. Panna
date well completed firm name county well located


LANDOWNER:	description of formations encountered	from	to
<u>James T. Taylor</u> <u>Courtland Miss.</u> (mailing address)			
	<u>" sand</u>	<u>20</u>	<u>40</u>
	<u>gravel</u>	<u>40</u>	<u>60</u>
	<u>gravel and sand</u>	<u>60</u>	<u>80</u>
	<u>" " "</u>	<u>80</u>	<u>100</u>
	<u>sand</u>	<u>100</u>	<u>120</u>
	<u>"</u>	<u>120</u>	<u>152</u>

WELL LOCATION:
sec 22 T 7 & 9 N R 3 E 15 F
4 miles south of Batesville
(distance) (direction) (nearest town)

WELL PURPOSE:
(home, irrigation, municipal, industrial)

- WELL COMPLETION DATA:
- (1) diameter (inches) 4
 - (2) total depth (feet) 152
 - (3) static water level (feet) 90 below above top of ground.
 - (4) casing PVC, 142,
(material) (depth)
4 if telescope see back.
(size)
 - (5) screen 10, 142
(length) (depth to top)
4, PVC
(size) (material)
 - (6) pump 3/4, 10
(HP) (yield gpm)
elec.
(type power)
 - (7) electric log no
(yes or no)
no
(organization running log)
 - (8) how well bottom plugged PVC
plug

CODED

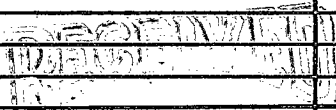

AUG 5 1975

DRILLERS REMARKS:

