

MISSISSIPPI DEPARTMENT OF NATURAL RESOURCES

Bureau of Land and Water Resources

Southport Mall

P.O. Box 10631

Jackson, Mississippi 39209

WATER WELL DRILLERS LOG

CODED

Panola
Q 29
5-27-81

5/27/81 date well completed
Dyersville Logging Service firm name
Panola county well located

LANDOWNER

Lamar Johnson

description of formations encountered

from

to

Batesville, Ms
(mailing address)

WELL LOCATION:

sec. 14 T 9 N R 8 E
3 miles W of Batesville
(distance) (direction) (nearest town)

WELL PURPOSE:


(home, irrigation, municipal, industrial)

WELL COMPLETION DATA:

- (1) diameter (inches) 16
- (2) total depth (feet) 93
- (3) static water level (feet) 6 below above top of ground.
- (4) casing Stainless
(material) (depth)
16 if telescopic see back.
(size)
- (5) screen 40
(length) (depth to top)
(size) (material)
- (6) pump Diesel
(HP) (yield gpm)
(type-power)
- (7) electric log _____
(yes or no)
- (8) how well bottom plugged Plate


<i>Run</i>	<i>13</i>	<i>23</i>
<i>soft clay</i>	<i>23</i>	<i>33</i>
<i>clay</i>	<i>33</i>	<i>43</i>
<i>hard granite</i>	<i>43</i>	<i>53</i>
<i>soft granite</i>	<i>53</i>	<i>63</i>
<i>granite</i>	<i>63</i>	<i>73</i>
<i>soft granite</i>	<i>73</i>	<i>83</i>
<i>soft granite</i>	<i>83</i>	<i>93</i>

CODED

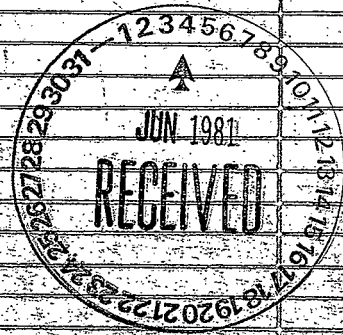

DRILLERS REMARKS:

①

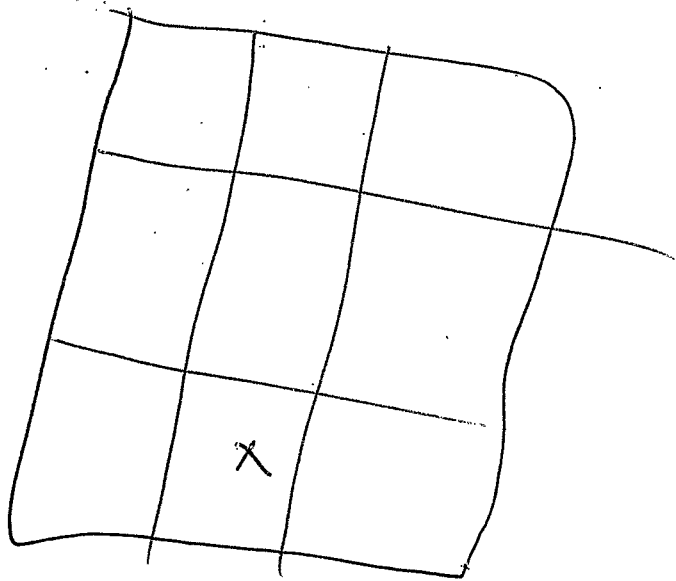

sec 14