

MISSISSIPPI DEPARTMENT OF NATURAL RESOURCES

Bureau of Land and Water Resources

Southport Mall

P.O. Box 10631

CODED

Jackson, Mississippi 39209

WATER WELL DRILLERS LOG

Q 33  
PANOLA  
4-84

GW01824

April 1984 date/well completed  
Leeper Drilling firm name  
Panola county well located

LANDOWNER: Billy Magee  
Hiway 6 West  
Batesville MS  
(mailing address)

description of formations encountered	from	to
<u>TOP CLAY</u>	<u>0</u>	<u>10</u>
<u>COARSE SAND</u>	<u>10</u>	<u>40</u>
<u>GRAVEL</u>	<u>40</u>	<u>80</u>

WELL LOCATION:  
sec. 18 T 9 N R 8 E  
1.7 S W W of Batesville  
(distance) miles (direction) of (nearest town)

WELL PURPOSE: irrigation  
(home, irrigation, municipal, industrial)

WELL COMPLETION DATA:  
(1) diameter (inches) 12"  
(2) total depth (feet) 80'  
(3) static water level (feet) 4 below above top of ground.  
(4) casing PVC 40'  
(material) (depth)  
If telescope see back.  
(size)  
(5) screen 40' 40'  
(length) (depth to top)  
12" PVC  
(size) (material)  
(6) pump 25 2000  
(HP) (yield gpm)  
3φ Electric  
(type power)  
(7) electric log NO  
(yes or no)  
(organization running log)

(8) how well bottom plugged Wood CAP

DRILLERS REMARKS:


DEPT. OF NATURAL RESOURCES  
BUREAU OF LAND & WATER RESOURCES

MAY 31 1984

RECEIVED

If well telescopes please sketch and show depths.

GROUND LEVEL

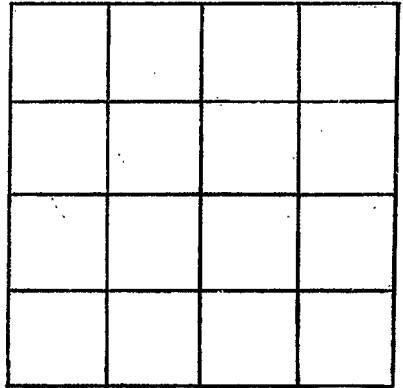

SECTION \_\_\_\_\_

Please indicate well location X.

ADDITIONAL INFORMATION

If more than one screen, show locations of each on sketch.