

Panola

Job # 8068

County: Tallahatchie
 Permit #: _____
 Driller: Pete's Well Drilling
 Date drilling completed: 6-11-08

Well Driller Report and Well Log

Mississippi Department of Environmental Quality
 Office of Land and Water Resources
 P.O. Box 10631
 Jackson, MS 39289-0631
 (601)961-5210
 (601)354-6938 (fax)

For Office Use Only:
 Aquifer: _____
 Well #: 946
 L. S. Elevation: _____
 E-log #: _____

State Law requires that this report be prepared by the driller in detail and filed with the Department within 30 days of completion of drilling of the well.

Well Owner Information	Well Location
Owner Name: <u>Balen Farms</u>	Latitude: <u>34° 16' 32.3"</u> Longitude: <u>90° 04' 52.8"</u>
Mailing Address: <u>7575 Dummy Line Rd</u>	Method of Lat/Long (circle one): <u>Conventional Survey</u>
<u>Batesville, MS 38606</u>	USGS quad, <u>Hand-held GPS</u> Survey-grade GPS
City State Zip Code	<u>NE 1/4 SE 1/4 Sec 30</u> <u>Twn 9S</u> <u>Rng 8W</u>
Telephone No. <u>(662) 934-5549</u>	Distance Direction Nearest Town <u>5</u> Miles <u>N</u> of <u>Crowder</u>

Well Data

Purpose of Well (circle one) Home Industrial Public Supply Irrigation Fish Culture Other: _____

Date well drilling started: 6-11-08 Date well drilling completed: 6-11-08

If flowing, method of flow regulation: Valve _____ Other (describe) _____

Static Water Level: 7 feet above or below (circle one) land surface Date measured: 6-11-08

Method of Measurement (circle one) steel tape electric tape air line other: _____

Hole depth: 100 Well depth: 100 Well grouted to a depth of 10 feet

Type of grout (circle one): Cement Bestonite Mix

Casing length: 60 feet Casing diameter: 12 inches Type of casing: PVC

Screen length: 40 feet Screen diameter: 12 inches Type of screen: PVC

Screen slot size: .032 inches Setting depth: From 60 feet to 100 feet

Type of completion (circle all applicable): Gravel packed Underreamed Telescoped Open hole Natural Development

Other (describe): _____

Top of lap pipe or reduction in casing: _____ feet. If telescoped or more than one screen, describe on back of page

Logs run (circle all applicable): No log run Electric Gamma Ray Density Sonic Neutron Other: _____

Name of organization running log(s): _____

I certify that the well was drilled, constructed, and completed in accordance with all applicable requirements of the Mississippi Department of Environmental Quality and/or the Mississippi Department of Health regulations and state laws.

Pete's Well Drilling 0430 Pete Spunator
 Print Name of Water Well Contractor and License No. Signature of Water Well Contractor

If well telescopes please sketch below and show depths.

No part 2

RECEIVED
 JUL 07 2008
 BY: OLWR


946

Ground Level

Description of Formations Encountered	From	To
clay	0	12
fine sand	12	30
COURSE SAND & GRAVEL	30	100

If more than one screen, show location of each on sketch

Sketch the property layout and include the following: 1) the well location; 2) any permanent structures on the property that may aid in locating the well; 3) any roads, power lines, or other items that may aid in locating the property and the well; 4) indicate direction.

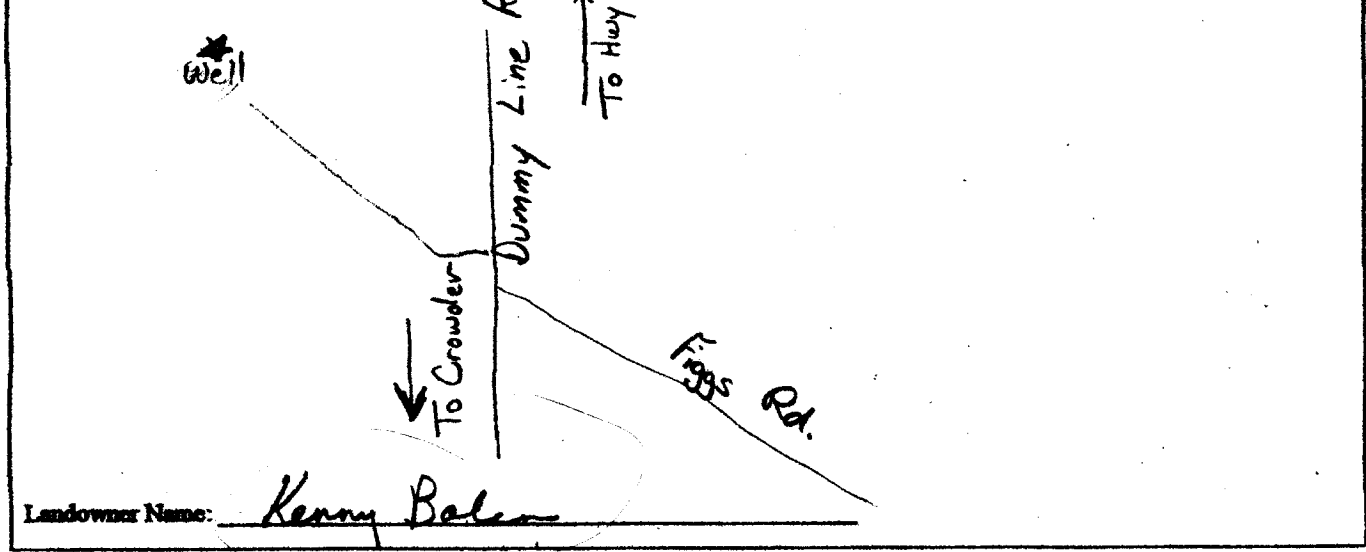

Landowner Name: Kenny Balen

[Signature]
Signature of Water Well Contractor

RECEIVED
JUL 07 2008
BY: OLWR