

Invoice

✓

County: panola
 Permit #: MS-GW-45608
 Driller: Will Young
 Date drilling completed: 8-8-2012

State Well Report
 Part 1 - Driller's Log
 Mississippi Department of Environmental Quality
 Office of Land and Water Resources
 P.O. Box 10631
 Jackson, MS 39289-0631
 (601)961-5210
 (601)354-6938 (fax)

For Office Use Only:
 Aquifer: _____
 Well #: Q52
 L.S. Elevation: _____
 E-log #: _____

State Law requires that this report be prepared by the license holder responsible for the work and filed with the Department at the above address within 30 days of completion of drilling of the well or borehole.

<p>Information on Well Owner (Landowner if borehole is not for a water well)</p> <p>Owner Name: <u>John Thomas</u> Mailing Address: <u>5142 Chapel Town Rd</u> <u>Batesville MS 38606</u> City State Zip Code Telephone No. () _____</p>	<p>Well or Borehole Location</p> <p>Latitude: <u>34° 18' 12.17"</u> Longitude: <u>90° 01' 28.14"</u> Method of Lat/Long (circle one): <u>Conventional Survey</u> USGS quad: <u>SE 1/4 SE 1/4 Sec 11 T11N R18W</u> Distance: <u>1</u> Miles Direction: <u>NW</u> of Nearest Town: <u>Batesville</u></p>
---	--

Well / Borehole Data

Date drilling started: 8-8 Date drilling completed: 8-8 Hole depth: 85' Hole diameter: 26"
 Location of the source of any surface water used for drilling: Local Pitch
 Method of dosing and volume of Chlorine used in drilling and development: N/A
 Logs run (circle all applicable): No log run Electric Gamma Ray Density Sonic Neutron Other _____
 Name of organization running log(s): N/A
 Purpose of borehole (check one): Water Well Geotechnical/Geological Investigation _____ Ground Source Heat Pump _____
 Seismic Survey _____ Other (describe) N/A
If drilling is not related to water well construction, skip the remainder of this block

Purpose of Well (check one): Home _____ Industrial _____ Public Supply _____ Irrigation Fish Culture _____ Other: _____
 If a flowing well, method of flow regulation: Valve N/A Other (describe) _____
 Static Water Level: 10' feet above or below (circle one) land surface Date measured: 4-8
 Method of Measurement (circle one): steel tape electric tape air line other: _____
 Well depth: 85 Well grouted to a depth of 45 feet Type of grout (circle one): Neat Cement Bentonite Mix
 Casing length: 45 feet Casing diameter: 16" inches Type of casing: PVC
 Screen length: 40 feet Screen diameter: 16" inches Type of screen: PVC
 Screen slot size: .050 inches Setting depth: From 45 feet to 85 feet
 Type of completion (circle all applicable): Gravel packed Underreamed Telescoped Open hole Natural Development
 Other (describe): N/A
 Top of lap pipe or reduction in casing: N/A feet. *If telescoped or more than one screen, describe on next page*


DH 22824
 12-243

RECEIVED
 AUG 07 2012
 BY: OLWR

Q52

The sketch below only required for water wells.

If well telescopes, show depths on sketch.

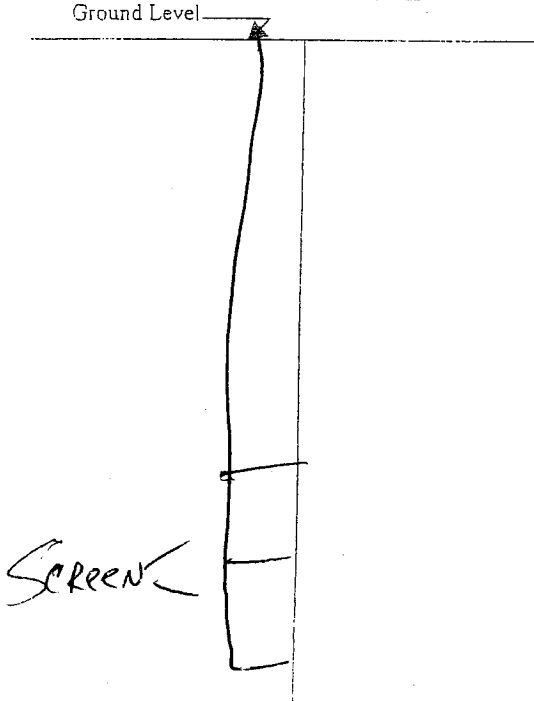


Description of formations encountered must be provided for all wells and boreholes, unless specifically exempted by regulations

Description of Formations Encountered	From (depth)	To (depth)
Clay	Ground Level	20'
Coarse Sand	20	60
Coarse Sand Gravel	60	85'

If more than one screen, show location of each on sketch

Sketch the property layout and include the following: 1) the well location; 2) any permanent structures on the property that may aid in locating the well; 3) any roads, power lines, or other items that may aid in locating the property and the well; 4) a north arrow.

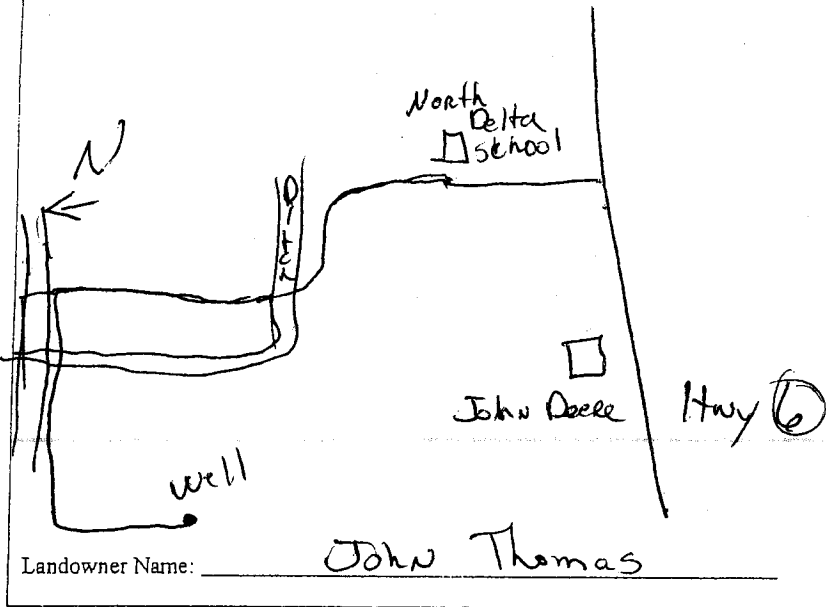

Form: OLWR-SWR-1A

I certify that the well/borehole was drilled, constructed, and completed in accordance with all applicable requirements of the Mississippi Department of Environmental Quality and the Mississippi Department of Health regulations, if applicable, and state laws.

Will Young 6-20-12
Print Name of Responsible Licensee and License No. Date

Will Young
Signature of Licensee

RECEIVED
AUG 07 2012
BY: OLWR

STATE WELL REPORT

Part 2

Pump Installer's Completion Report

Mississippi Department of Environmental Quality
Office of Land and Water Resources
P.O. Box 2309
Jackson, MS 39225
(601) 961-5210
(601) 961-5228 (fax)

County: PANOLA
Permit #: GW-45608
Driller: Young's Custom
Date drilling completed:
Copy information from block on Part 1

For Office Use Only:
Aquifer: Q 53
Well #:
Elevation:

This part of the report must be completed by a licensed water well contractor or a licensed pump installer. A copy of Part 1 of the report must be attached and both parts filed with the Department at the above address within 30 days of well completion.

Well Owner Information: Owner Name: THOMAS FARMS, Mailing Address: 5142 CHAPEL TOWN RD, BATESVILLE, MS 38606, Telephone No. (662) 563-3679
Well Location: Latitude: 34.18, 40.96, Longitude: 90.00, 8.13, Method of Lat/Long: SE 1/4 SE 1/4 Sec 11 T 9S R 8W, Distance: 2 Miles West of BATESVILLE

Pump Type: Air Lift, Bucket, Centrifugal, Jet, Piston, Rotary, Submersible, Turbine, Flowing Well
Power Type: Diesel Engine, Gasoline Engine, Natural Gas, Electric Motor, Hand, Tractor PTO, Windmill, Other
Horse Power Rating of Motor: 80
Setting Depth: 70 feet
Number of Stages: 1

Pump Test Data: Date Well Tested, Static Water Level (A), Pumping Water Level (B), Drawdown [(B) - (A)], Test Pumping Rate, Duration of Pump Test
Method of Measuring Water Level: Air Line, Electric Measuring Line, Steel Tape
Other (specify):
For flowing well, measured shut in head:
Well yielded GPM with a drawdown of feet after hours of pumping

This is for (check one): New Well, Replacement of Existing Pump, Repair of Existing Pump

I HEREBY CERTIFY that the above statements are true to the best of my knowledge.
DAVID P. HOLT 0-752P
Signature of Pump Installer

RECEIVED
Form: OLWR-SWR-1C (07-09)
AUG 24 2012
BY: OLWR