

PANOLA
Q 2001
1-28-77

MISSISSIPPI
BOARD OF WATER COMMISSIONERS
416 North State Street
Jackson, Mississippi 39201

15F

WATER WELL DRILLERS LOG

Jan. 28 1977 Lipe Well Co. Panola
date well completed firm name county well located

LANDOWNER:	description of fomations encountered	from	to
Willie B. Webb			
Batesville Ms.	red Muddy sand	20	40
(mailing address)	white sand	40	60
	ll ll	60	81

WELL LOCATION:
sec. 3 T 9 N R 8 W
6 miles West of Batesville
(distance) (direction) (nearest town)

WELL PURPOSE:
(home) Irrigation, municipal, industrial

- WELL COMPLETION DATA:
- (1) diameter (inches) 4
 - (2) total depth (feet) 81
 - (3) static water level (feet) 15 below above top of ground.
 - (4) casing PVC 71 (material) (depth)
4 (size) if telescope see back.
 - (5) screen 10 71 (length) (depth to top)
4 PVC (size) (material)
 - (6) pump 3/4 10 (HP) (yield gpm)
elec. (type power)
 - (7) electric log NO (yes or no)
NO (organization running log)
 - (8) how well bottom plugged PVC CAP


DRILLERS REMARKS:

RECEIVED
FEB 22 1977

MISS. Bd. OF WATER COMM.

If well telescopes please sketch and show depths.

GROUND LEVEL

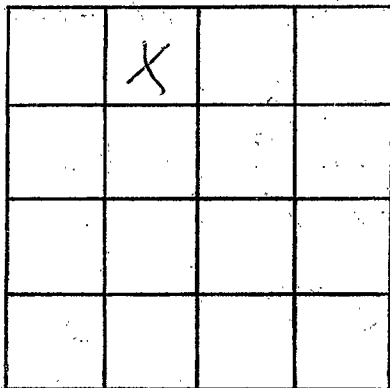

SECTION 3

Please indicate well location X.

ADDITIONAL INFORMATION

If more than one screen, show locations of each on sketch.