

PANOLA

2004

4-26-78

MISSISSIPPI
 BOARD OF WATER COMMISSIONERS
 416 North State Street
 Jackson, Mississippi 39201

WATER WELL DRILLERS LOG

4-26

1978 Life Well Co. Panola

date well completed

firm name

county well located

LANDOWNER:

Warneda Jackson
 Batesville MS.
 (mailing address)

description of formations encountered

TOP Soil
 Sand

from

to

0 20
 20 60

WELL LOCATION:

sec. 33 T. 9 N. R. 2 E. P.
 4 miles West of Batesville
 (distance) (direction) (nearest town)

WELL PURPOSE:

(home) irrigation, municipal, industrial

WELL COMPLETION DATA:

- (1) diameter (inches) 4
- (2) total depth (feet) 60
- (3) static water level (feet) 20 below above top of ground.
- (4) casing PVC 50 (material) (depth)
 4 (size) if telescope see back.
- (5) screen 10 50 (length) (depth to top)
 4 PVC (size) (material)
- (6) pump 3/4 10 (HP) (yield gpm)
 elec. (type power)
- (7) electric log no (yes or no)
 no (organization running log)
- (8) how well bottom plugged PVC CAP


DRILLERS REMARKS:

RECEIVED
 MAY 8 - 1978

MISS. BD. OF WATER COMMISSIONERS

If well telescopes please sketch and show depths.

GROUND LEVEL

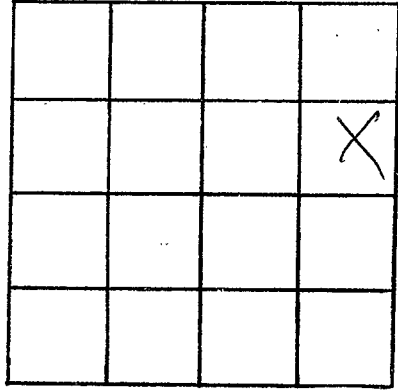

SECTION 33

Please indicate well location X.

ADDITIONAL INFORMATION

A series of horizontal lines for writing additional information, starting below the 'ADDITIONAL INFORMATION' header and extending to the bottom of the page.

If more than one screen, show locations of each on sketch.