

Panola
2006

MISSISSIPPI
BOARD OF WATER COMMISSIONERS
416 North State Street
Jackson, Mississippi 39201

8-20-79
8-20-79

WATER WELL DRILLERS LOG

1979 Lipe Well Co. Panola

date well completed

firm name

county well located

LANDOWNER:	description of formations encountered	from	to
A. C. Clark Jr.	Topsoil	0	20
Batesville Ms.	red sand	20	40
(mailing address)	gravel	40	60
	ic	60	80
	sand and gravel	80	100
	sand	100	144

WELL LOCATION:
sec. 33 T 9 N R 8 E
8 miles West of Batesville
(distance) (direction) (nearest town)

WELL PURPOSE:
(home, irrigation, municipal, industrial)

WELL COMPLETION DATA:

(1) diameter (inches) 4

(2) total depth (feet) 144

(3) static water level (feet) 90 below top of ground.

(4) casing PVC 134 (material) (depth)

4 (size) if telescope see back.

(5) screen 10 134 (length) (depth to top)

4 PVC (size) (material)

(6) pump 3/4 10 (HP) (yield gpm)

elec. (type power)

(7) electric log NO (yes or no)

NO (organization running log)

(8) how well bottom plugged PVC CAP

DEPT. OF NATURAL RESOURCES
BUREAU OF LAND & WATER RESOURCES


OCT 16 1979

RECEIVED

DRILLERS REMARKS:

If well telescopes please sketch and show depths.

GROUND LEVEL

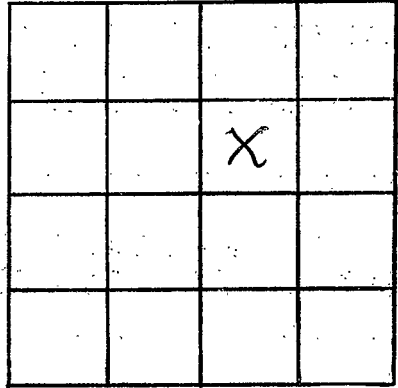

SECTION 33

Please indicate well location X.

ADDITIONAL INFORMATION

If more than one screen, show locations of each on sketch.