

PANOLA
Q 2007
10-23-78

**MISSISSIPPI
BOARD OF WATER COMMISSIONERS**
416 North State Street
Jackson, Mississippi 39201

WATER WELL DRILLERS LOG

10-23 1978 Life Well Co. Panola
 date well completed firm name county well located

LANDOWNER:
 Danny Meghee
 Batesville MS,
 (mailing address)

WELL LOCATION:
 sec. 21 T. 9 N. R. 4 E
 4 miles West of Batesville
 (distance) (direction) (nearest town)

WELL PURPOSE:
 (home irrigation, municipal, industrial)

WELL COMPLETION DATA:

(1) diameter (inches) 4

(2) total depth (feet) 123

(3) static water level (feet) 20 below top of ground.

(4) casing PVC 113
 (material) (depth)

4 If telescope see back.
 (size)

(5) screen 10 113
 (length) (depth to top)

4 PVC
 (size) (material)

(6) pump 3/4 10
 (HP) (yield gpm)

elec.
 (type power)

(7) electric log no
 (yes or no)

no
 (organization running log)

(8) how well bottom plugged PVC
 plug

description of formations encountered	from	to
TOP SOILS	0	20
red sand	20	40
gravel	40	60
"	60	70
white clay	70	80
white sand	80	100
" "	100	123

RECEIVED


DEC - 4 1978

MISS. BD. OF WATER COMM

DRILLERS REMARKS:

If well telescopes please sketch and show depths.

GROUND LEVEL

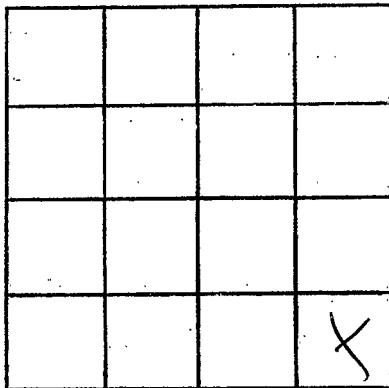

SECTION 21

Please indicate well location X.

ADDITIONAL INFORMATION

If more than one screen, show locations of each on sketch.