

PANOLA

MISSISSIPPI  
BOARD OF WATER COMMISSIONERS  
416 North State Street  
Jackson, Mississippi 39201

Q 2008

6-7-80

WATER WELL DRILLERS LOG

6-7-80

19 North Miss Well No. Panola

date well completed

firm name

county well located

LANDOWNER: Ann Reed

description of formations encountered

from

to

Batesville Miss  
(mailing address)

Clay

0 25

Red Granite

25 35

WELL LOCATION:

sec. 25 T28 N R. 3 E  
2 9 S of Batesville  
(distance) (direction) (nearest town)

Clay & Sand Str

35 135

Sand

135 160

WELL PURPOSE: Home  
(home, irrigation, municipal, industrial)

WELL COMPLETION DATA:

- (1) diameter (inches) 4"
- (2) total depth (feet) 160
- (3) static water level (feet) 95 below top of ground.
- (4) casing Plastic 160  
(material) (depth)
- (size) If telescope see back.
- (5) screen 10' 150  
(length) (depth to top)
- 4" Plastic slot  
(size) (material)
- (6) pump 3/4 10  
(HP) (yield gpm)
- Elec  
(type power)
- (7) electric log No  
(yes or no)

(organization running log)


(8) how well bottom plugged Wash Bot

DRILLERS REMARKS:

DEPT. OF NATURAL RESOURCES  
BUREAU OF LAND & WATER RESOURCES  
RECEIVED  
RECEIVED  
RECEIVED

If well telescopes please sketch and show depths.

GROUND LEVEL

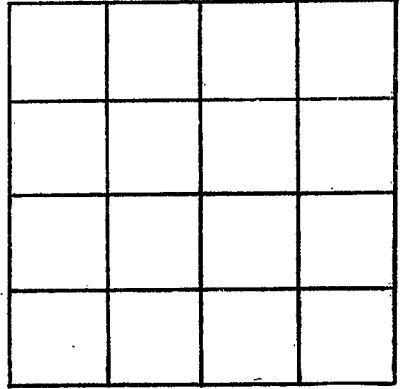

SECTION \_\_\_\_\_

Please indicate well location X.

ADDITIONAL INFORMATION

If more than one screen,  
show locations of each on sketch.