

PANOLA
 Q 2009
 6/5/81

MISSISSIPPI
 BOARD OF WATER COMMISSIONERS
 416 North State Street
 Jackson, Mississippi 39201

WATER WELL DRILLERS LOG

16-5 1981 Big STREAM PANOLA
 date well completed firm name county well located


LANDOWNER: Dr. Hudson
 Batesville Miss
 (mailing address)

description of formations encountered	from	to
Blue Clay	0	40
Gravel	40	120
SAND	120	160

WELL LOCATION:
 sec 27 T 28 N R 3 E
 S W
 6 miles S W of BATESVILLE
 (distance) (direction) (nearest town)

WELL PURPOSE: TRAILER
 (home, irrigation, municipal, industrial)

- WELL COMPLETION DATA:
- (1) diameter (inches) 4"
 - (2) total depth (feet) 160
 - (3) static water level (feet) 100 ^{below} top of ground.
 - (4) casing PVC 150
 (material) (depth)
 4" if telescope see back.
 (size)
 - (5) screen 100/10FT 150
 (length) (depth to top)
 4" PVC
 (size) (material)
 - (6) pump 3/4 HP 10
 (HP) (yield gpm)
 ELECT
 (type power)
 - (7) electric log NO
 (yes or no)

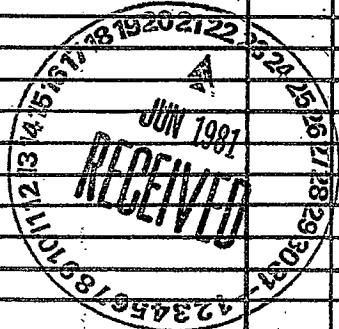


(organization running log)
 (8) how well bottom plugged SHARK
 WASH BOTTLE

DRILLERS REMARKS:

If well telescopes please sketch and show depths.

GROUND LEVEL

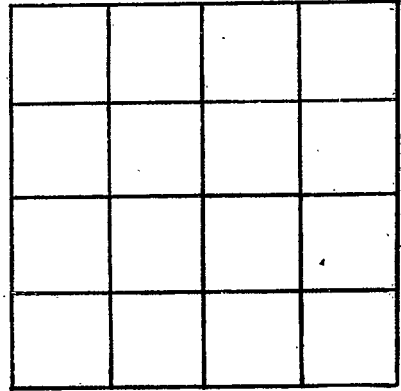

SECTION _____

Please indicate well location X.

ADDITIONAL INFORMATION

If more than one screen,
show locations of each on sketch.