

Panola
Q 2010

**MISSISSIPPI
 BOARD OF WATER COMMISSIONERS
 416 North State Street
 Jackson, Mississippi 39201**

WATER WELL DRILLERS LOG

4/16/84 19 L. Pellier & Sons Panola
 date well completed firm name county well located

LANDOWNER: <u>L. M. H. Morris</u>	description of formations encountered	from	to
<u>Batesville</u>			
<u>Armed</u> (mailing address)	<u>Clay</u> <u>Sand</u>	<u>0</u>	<u>20</u> <u>74</u>
WELL LOCATION:			
sec. <u>35</u> T. <u>9</u> N. R. <u>3</u> (E) <u>6</u> miles <u>W</u> of <u>Batesville</u> (distance) (direction) (nearest town)			
WELL PURPOSE: (home, irrigation, municipal, industrial)			
WELL COMPLETION DATA:			
(1) diameter (inches) <u>4</u>			
(2) total depth (feet) <u>72</u>			
(3) static water level (feet) <u>10</u> below above top of ground.			
(4) casing <u>PVC</u> , <u>66</u> (material) (depth) <u>4"</u> (size) if telescope see back.			
(5) screen <u>8</u> , <u>66</u> (length) (depth to top)			
(6) pump <u>1/2</u> , <u>10</u> (HP) (yield gpm) <u>elec</u> (type power)			
(7) electric log <u>X</u> (yes or no)			
(8) how well bottom plugged <u>PVC</u> <u>cap</u>			
DRILLERS REMARKS:			


DEPT. OF NATURAL RESOURCES
 BUREAU OF LAND & WATER RESOURCES

APR 23 1984

RECEIVED

If well telescopes please sketch and show depths.

GROUND LEVEL

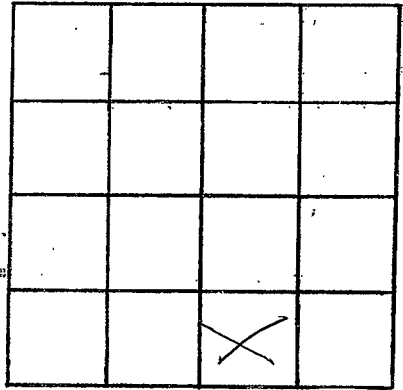

SECTION _____

Please indicate well location X.

ADDITIONAL INFORMATION

If more than one screen, show locations of each on sketch.