

ANOLA
Q 2011

MISSISSIPPI DEPARTMENT OF NATURAL RESOURCES
Bureau of Land and Water Resources
Southport Mall
P.O. Box 10631
Jackson, Mississippi 39209
WATER WELL DRILLERS LOG

3-28 1991 date well completed
LIFE WELL Supply Co. INC firm name
PANOLA county well located

LANDOWNER: Huron Smith
Batesville ms. 38606
(mailing address)
WELL LOCATION: 9 S R 8 W
sec. 9 8 R. 8 W. #
3 miles WEST of BATESVILLE
(distance) (direction) (nearest town)

description of formations encountered	from	to
	<u>Top soil - clay - sand</u>	<u>0</u>
<u>sand</u>	<u>20</u>	<u>40</u>

WELL PURPOSE: FARM USE
(home, irrigation, municipal, industrial)

- WELL COMPLETION DATA:
- (1) diameter (inches) 4
 - (2) total depth (feet) 41
 - (3) static water level (feet) _____ below/above top of ground.
 - (4) casing PVC 31
(material) (depth)
4 if telescope see back.
(size)
 - (5) screen 10 31
(length) (depth to top)
4 PVC
(size) (material)
 - (6) pump 1 _____
(HP) (yield gpm)
(type power)
 - (7) electric log _____
(yes or no)
(organization running log)
 - (8) how well bottom plugged Capped

RECEIVED
MARCH 16 1991


APR 16 1991

Dept. of Environmental Quality
Bureau of Land & Water Resources

DRILLERS REMARKS: _____

If well telescopes please sketch and show depths.

GROUND LEVEL

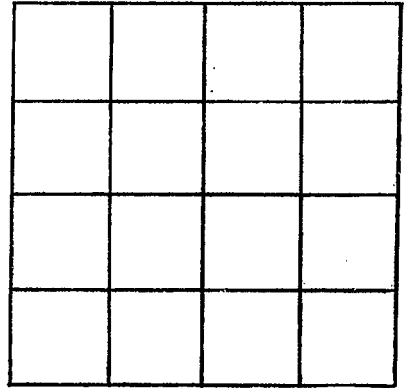

SECTION _____

Please indicate well location X.

ADDITIONAL INFORMATION

If more than one screen,
show locations of each on sketch.