

MISSISSIPPI DEPARTMENT OF ENVIRONMENTAL QUALITY
Bureau of Land and Water Resources

P. O. Box 10631
Jackson, MS 39289-0631
WATER WELL DRILLERS LOG

COUNTY WELL-LOCATED Vanola	PERMIT NUMBER
WELL NUMBER 4 CODED 2012	NAME OF DRILLING FIRM
DATE WELL COMPLETED 9-5-92	Repair well & supply

NAME & MAILING ADDRESS OF LANDOWNER Pete Horton			
Westmoreland Hts			
Balmain, Ms 38606			
WELL LOCATION:	SEC	TOWNSHIP	RANGE
	16	9	8 (E)
			W
DISTANCE	DIRECTION	NEAREST TOWN	
OTHER LANDMARK Westmoreland Hts Blvd			
WELL PURPOSE: <input checked="" type="checkbox"/> Home Irrigation <input type="checkbox"/> Municipal, Industrial, Fish Pond, etc.			

PUMP DATA		
PUMP TYPE (Circle One): <input checked="" type="radio"/> Submersible <input type="radio"/> Turbine <input type="radio"/> Jet <input type="radio"/> Flowing Well, Other (Describe) _____		
POWER TYPE (Circle One): <input checked="" type="radio"/> Electric <input type="radio"/> Tractor <input type="radio"/> Diesel <input type="radio"/> Gasoline <input type="radio"/> Butane, Other (Describe) _____ H/P _____		
Pump Capacity (GPM)	No. of Stages	Setting Depth
35		15 FT.
PUMP TEST		
Well yielded 35 GPM with		
a drawdown of 20 ft.		
after 3 hours of pumping		

WELL DATA		
Well Depth 150'	Casing Diameter (In.) 4"	Casing Length (Ft.) 130
Type of Casing PVC	Hole Depth 150	Depth to Static Water Level 90'
TYPE OF COMPLETION: (Circle One or More): <input checked="" type="checkbox"/> Grave Packed, <input type="checkbox"/> Underreamed, <input type="checkbox"/> Telescoped, <input checked="" type="checkbox"/> Natural Development, <input type="checkbox"/> Open Hole, <input type="checkbox"/> Other (Describe) _____		
Top of Lap Pipe or Reduction in Casing		
FEET <input type="checkbox"/> IF TELESCOPED OR MORE THAN ONE SCREEN: USE BACK PAGE		

LOG DATA	
TYPE OF LOG RUN (Circle One): <input checked="" type="radio"/> No Log Run <input type="radio"/> Electric, Gamma Ray, Density, Sonic, Neutron, Other (Describe) _____	
Name of Organization Running Log	

SCREEN DATA		
Diameter - Inches 4"	Length - Feet 20'	Slot Size - Inches .010
Screen Type PVC	Depth to Bottom - Feet 150.	

GEOLOGIC DATA (Office Use Only)			
Surface Elev.	Geologic Unit	Unit Thickness	Depth to Top
Subs. SWL	Date	Analysis	Aquifer Test


Driller's Remarks

DESCRIPTION OF FORMATIONS ENCOUNTERED	FROM	TO	FORMATIONS (Continued)	FROM	TO
Top soil	0	15	RECEIVED JUN 03 1993		
SAND	15	20			
SAND : Gravel	20	80			
Clay	80	90			
SAND	90	130			

IF MORE SPACE IS NEEDED, USE BACK

If well telescopes please
sketch and show depths.

GROUND LEVEL

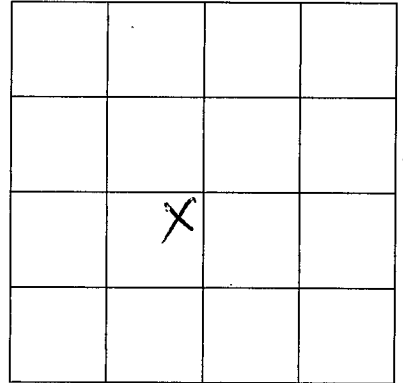

SECTION 16

Please indicate well location X.

ADDITIONAL INFORMATION

If more than one screen,
show location of each on sketch.