

**MISSISSIPPI
BOARD OF WATER COMMISSIONERS**
416 North State Street
Jackson, Mississippi 39201

WATER WELL DRILLERS LOG

Panola
R

Seeley 31
date well completed

1984 Lipe Well
firm name

Panola
county well located

LANDOWNER: <u>Fred Broy</u> <u>Boxeaville MS</u>	description of formations encountered	from	to
(mailing address)	<u>clay</u>	<u>0</u>	<u>8</u>
	<u>gravel</u>	<u>8</u>	<u>10</u>
WELL LOCATION:	<u>Sand + clay</u>	<u>10</u>	<u>28</u>
sec. <u>15</u> T <u>9</u> N R <u>7</u> E	<u>Rock</u>	<u>28</u>	<u>28</u>
<u>1</u> miles <u>SE</u> of <u>Boxeaville</u>	<u>Sand + clay</u>	<u>28</u>	<u>40</u>
(distance) (direction) (nearest town)	<u>Sand</u>	<u>40</u>	<u>85</u>
WELL PURPOSE: <u>drinking</u>	<u>Soft clay</u>	<u>75</u>	<u>105</u>
(home, irrigation, municipal, industrial)	<u>SAND</u>	<u>105</u>	<u>160</u>
WELL COMPLETION DATA:			
(1) diameter (inches) <u>4 1/2</u>			
(2) total depth (feet) <u>160</u>			
(3) static water level (feet) <u>90</u> ^{below} / _{above} top of ground.			
(4) casing <u>PVC</u> , <u>150</u> (material), (depth)			
<u>4</u> (size) if telescope see back.			
(5) screen <u>10</u> , <u>150</u> (length), (depth to top)			
<u>4</u> , <u>PVC</u> (size), (material)			
(6) pump <u>1</u> , <u>20</u> (HP), (yield gpm)			
<u>elec</u> (type power)			
(7) electric log <u>No</u> (yes or no)			
(organization running log)			
(8) how well bottom plugged <u>Cap</u>			
DRILLERS REMARKS:			


MISSISSIPPI DEPARTMENT OF AGRICULTURE
BUREAU OF NATURAL RESOURCES
LAND & WATER RESOURCES

OCT 16 1984

RECEIVED

If well telescopes please sketch and show depths.

GROUND LEVEL

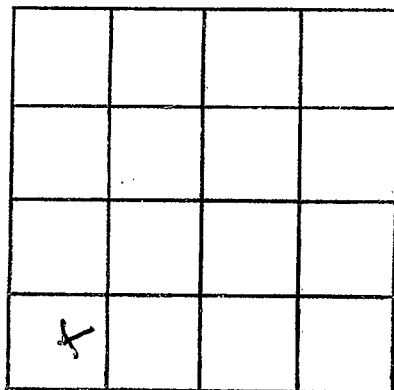

SECTION _____

Please indicate well location X.

ADDITIONAL INFORMATION

If more than one screen, show locations of each on sketch.