

PANOLA
R

WATER WELL DRILLERS LOG

6-11-61

Date: June 11, 1961

Driller: Robert E. Rathoff

Panola
Co.

(Name)

(1) Owner of Land: South Side Cement
(Name)
Batesville, Miss
(Address)

(2) Location: 1/4, 1/4, Sec. T. R.
 miles of
(distance) (direction) (Nearest Town)

(3) Topography: (Hilly) (Flat) (Level)

(4) Purpose of Well:
(Domestic Irrigation
Municipal, Industrial, Other)

Description & Color of Materials Sand, Clay, Red Clay, Shell, etc.	Thick- ness Feet	Depth Feet
Sand-gravel	0	92
white sand	92	210
Rock	210	
Brown shale	210	227
shale sand streaks	227	460
shale rock	460	510
white sand	510	554
sand shale streaks	554	619
lumber	619	727
sandy shale	727	1026
sand	1026	1120

Information upon completion of well:

(1) Diameter 4x6 inches.

(2) Total Depth 1120 feet.

(3) Water Level feet below top of ground.

(4) Cased to 1120, Size 4x6


(5) Screen: Size 4", Length 40'

(6) Were any formations sealed against pollution?
 yes, no.

If YES depth of formation

Why

Drillers Remarks:

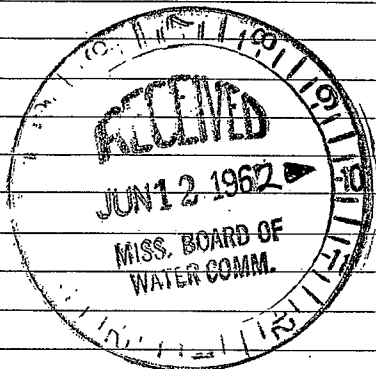

(Use Back Side)

Well No.

