

PANOLA

R

WATER WELL DRILLERS LOG

11-26-62

Date: 11-26, 1962, Driller: J B Cain County Panola

(Name)

(1) Owner of Land	Description & Color of Materials Sand, Clay, Red Clay Shell, etc.	Thick- ness Feet	Depth Feet
Edward Swindle (Name)	Bro of Sand	0	10
Batesville miss (Address)		10	30
(2) Location: 1/4, 1/4, Sec. T R			
1 miles west, of Batesville (distance) (direction) (Nearest Town)			
(3) Topography: (Hilly) (Flat) (Level)			
(4) Purpose of Well: Home (Domestic Irrigation Municipal, Industrial, Other)			


Information upon completion of well:

- (1) Diameter 1 1/4 inches.
- (2) Total Depth 30 feet.
- (3) Water Level 10 feet below top of ground.
- (4) Cased to 30, Size 1 1/4.
- (5) Screen: Size 1 1/4, Length 5 FT.
- (6) Were any formations sealed against pollution?
_____ yes, _____ no.

If YES depth of formation _____

Why _____

Drillers Remarks: _____

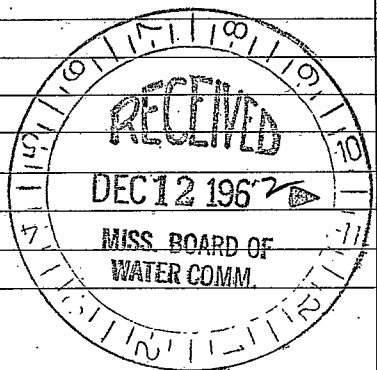

(Use Back Side)

Well No.

