

R

6-28-63

WATER WELL DRILLERS LOG

Date: 6-28, 1963, Driller: J B Cain County: Panola

(Name)

(1) Owner of Land: Charley Florence  
(Name)  
Batesville Miss  
(Address)

Description & Color of Materials  
Sand, Clay, Red Clay, Shell, etc.  
Bro Ch  
Gravel  
Sand

Thick-  
ness  
Feet  
Depth  
Feet  
0 45  
45 110  
110 157

(2) Location: 1/4, 1/4, Sec. T R  
3 miles SOUTH of Batesville  
(distance) (direction) (Nearest Town)

(3) Topography:  (Hilly)  (Flat)  (Level)

(4) Purpose of Well: Home  
(Domestic Irrigation  
Municipal, Industrial, Other)

Information upon completion of well:


- (1) Diameter 4 inches.
- (2) Total Depth 167 feet.
- (3) Water Level 130 feet below top of ground.
- (4) Cased to 167, Size 4
- (5) Screen: Size 1/4 Stainless, Length 10 FT
- (6) Were any formations sealed against pollution?

yes, no.

If YES depth of formation

Why

Drillers Remarks:

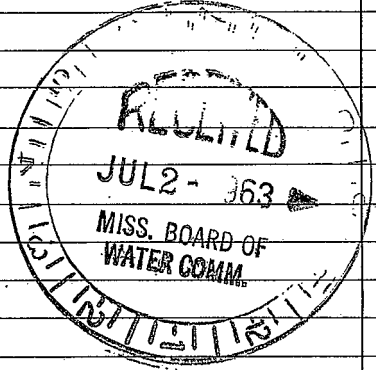

Well No.

(Use Back Side)

