

PANOLA MISSISSIPPI BOARD OF WATER COMMISSIONERS

R

11-6-64

WATER WELL DRILLERS LOG

Date: 11-6, 1964, Driller: J B Cain County Panola

(Name)

(1) Owner of Land: Henry Hefner
(Name)
Batesville Miss
(Address)

Description & Color of Materials
 Sand, Clay, Red Clay, Shell, etc.

Thick-
ness
Feet

Depth
Feet

<u>Clay</u>	<u>0</u>	<u>30</u>
<u>Sand & Sh</u>	<u>30</u>	<u>100</u>
<u>Sand</u>	<u>100</u>	<u>160</u>

(2) Location: 1/4, 1/4, Sec. T. R.

2 miles E of Batesville
(distance) (direction) (Nearest Town)

(3) Topography: (Hilly) (Flat) (Level)

(4) Purpose of Well: Home
(Domestic Irrigation
 Municipal, Industrial, Other)

Information upon completion of well:

(1) Diameter 2" inches.

(2) Total Depth 160 feet.

(3) Water Level 110 feet below top of ground.

(4) Cased to 160, Size 4"


(5) Screen: Size 2", Length 8 FT

(6) Were any formations sealed against pollution?
1" Pipe at 160 FT
also 2" Form Thread
on end of 2" Pipe

yes no
 If YES depth of formation

Why

Drillers Remarks:

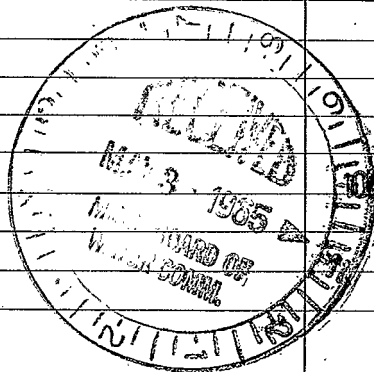

(Use Back Side)

Well No.

