

R
11-6-64

WATER WELL DRILLERS LOG

Date 11-6, 1964, Driller: J B Cain County Panola
(Name)


(1) Owner of Land: Henry Hefner
(Name)
Batesville Miss
(Address)

(2) Location: 1/4, 1/4, Sec. T R R
2 miles E of Batesville
(distance) (direction) (Nearest Town)

(3) Topography: ✓
(Hilly) (Flat) (Level)

(4) Purpose of Well: Home
(Domestic Irrigation
Municipal, Industrial, Other)

Description & Color of Materials Sand, Clay, Red Clay, Shell, etc.	Thick- ness Feet	Depth Feet
<u>Gravel</u>	<u>0</u>	<u>30</u>
<u>Gravel + sand</u>	<u>30</u>	<u>100</u>
<u>Sand</u>	<u>100</u>	<u>160</u>

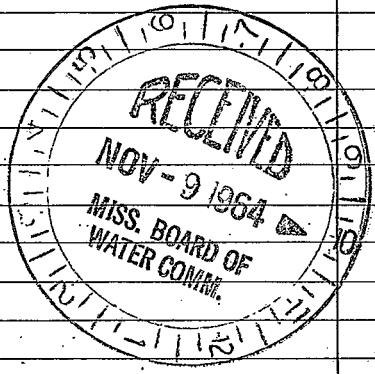

Information upon completion of well:

(1) Diameter 4 inches.

(2) Total Depth 160 feet.

(3) Water Level 110 feet below top of ground.

(4) Cased to 160, Size 4"

(5) Screen: Size 4, Length 8 FT

(6) Were any formations sealed against pollution?
_____ yes, _____ no.

If YES depth of formation _____

Why _____

Drillers Remarks: _____

(Use Back Side)

Well No.

