

PANOLA

MISSISSIPPI BOARD OF WATER COMMISSIONERS

R

11-23-65

WATER WELL DRILLERS LOG

Date: 11-23, 1965, Driller: Jerry Robinson County Panola (Name)

(1) Owner of Land: Mrs. Ed Swindell (Name)

Batesville, Miss (Address)

(2) Location: 1/4, 1/4, Sec. T R

2 1/2 miles S, of Batesville (distance, direction, Nearest Town)

(3) Topography: (Hilly) (Flat) (Level)

(4) Purpose of Well: Home (Domestic Irrigation, Municipal, Industrial, Other)

Description & Color of Materials Sand, Clay, Red Clay, Shell, etc.

Thickness Feet

Depth Feet

Clay 10 10

Sand + Clay 10 20

Sand 20 40

Information upon completion of well:

(1) Diameter 2 inches.

(2) Total Depth 40 feet.

(3) Water Level 12 feet below top of ground.

(4) Cased to 35, Size 2 in

(5) Screen: Size 3 in, Length 5 ft


(6) Were any formations sealed against pollution? yes, no.

If YES depth of formation

Why

Drillers Remarks: Plastic well

outside screen

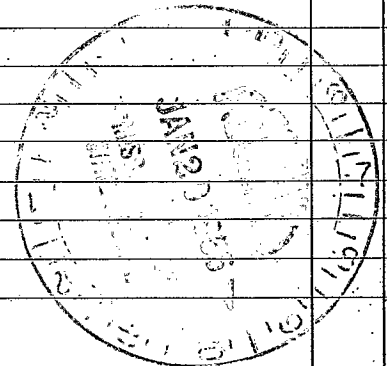

(Use Back Side)

Well No.

