


If well telescopes please
sketch and show depths.

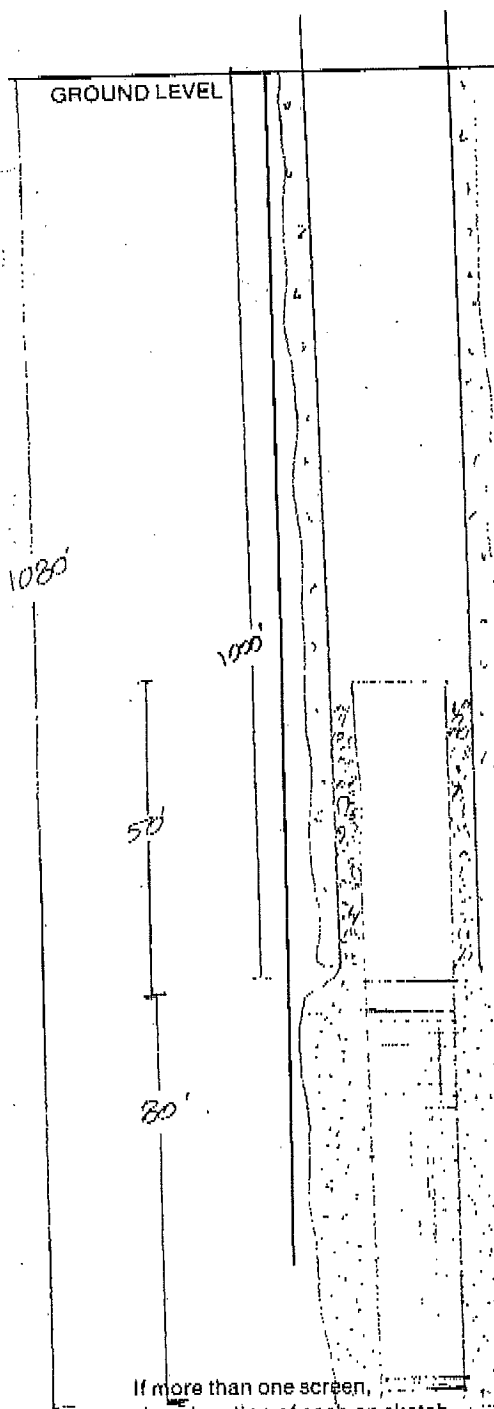

If more than one screen,
show location of each on sketch.

RECEIVED

SEP 25 1990

Department of Natural Resources
Bureau of Land & Water Resources

SECTION _____

Please indicate well location X.

ADDITIONAL INFORMATION

Sand	420-440
Sand	440-460
Sand	460-480
Sand	480-500
Sand	500-520
Sand	520-540
Sand	540-560
Rock at 560" then clay (red)	560-580
Med hard clay	580-600
Med hard clay	600-620
Med hard clay - streaks sand	620-640
Med hard clay	640-660
Med hard clay	660-680
Med hard clay	680-700
Med hard clay	700-720
Med hard clay	720-740
Med hard clay	740-760
Med hard clay	760-780
Med hard clay - streak of sand	780-800
Mostly sand with clay streaks	800-820
Mostly sand - little clay	820-840
Sand back in clay	840-860
Med hard clay	860-880
Med hard clay	880-900
Med hard clay	900-920

SECURITY
WEL