

MISSISSIPPI
BOARD OF WATER COMMISSIONERS
416 North State Street
Jackson, Mississippi 39201

CODED

WATER WELL DRILLERS LOG

PANOLA
R 13
2-10-71

Feb. 10 1971 date well completed
J. B. Cain firm name
Panola county well located

LANDOWNER: Dr. Walter Hudson

description of formations encountered

from to

Buck Shot Clay	0	12
WATER SAND	12	14
RED SAND	14	20
WATER SAND	20	50

(mailing address)

WELL LOCATION:

sec. 8 T 9 N R 7 E
miles _____ of _____
(distance) (direction) (nearest town)

WELL PURPOSE: Home
(home, irrigation, municipal, industrial)

WELL COMPLETION DATA:

- (1) diameter (inches) 4"
- (2) total depth (feet) 50'
- (3) static water level (feet) 12' below above top of ground.
- (4) casing 4" pipe 45'
(material) (depth)
4'
(size) if telescope see back.
- (5) screen 5 50"
(length) (depth to top)
4 brand pack
(size) (material)
- (6) pump 1/2 _____
(HP) (yield gpm)
220
(type power)
- (7) electric log NO
(yes or no)
- _____
(organization running log)
- (8) how well bottom plugged wash bottom

CODED


APR - 6 1971

DRILLERS REMARKS:

MISS. BD. OF
WATER COMM.

If well telescopes please sketch and show depths.

GROUND LEVEL

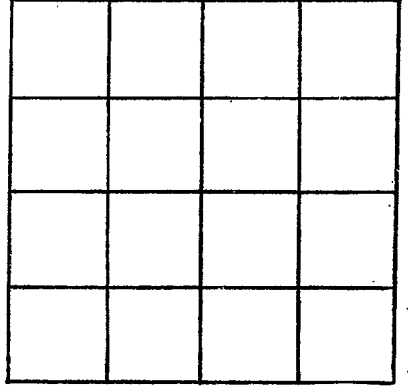

SECTION _____

Please indicate well location X.

ADDITIONAL INFORMATION

If more than one screen, show locations of each on sketch.