

SL09 #32

MISSISSIPPI
BOARD OF WATER COMMISSIONERS
416 North State Street
Jackson, Mississippi 39201
WATER WELL DRILLERS LOG

CODED

Panola
R19
6-7-68
MGS

June 7, 1968 19 Luther Ratliff Panola
date well completed firm name county well located

LANDOWNER: Miss. State Hwy Dept
Batesville, Miss 38606
(mailing address)

WELL LOCATION: 21. Sta. 335+92.0
sec. 34 T. 9 N. R. 17 E.
S W
1 miles WEST of Courtland
(distance) (direction) (nearest town)

WELL PURPOSE: Rest Area
(home, irrigation, municipal, industrial)

WELL COMPLETION DATA:

(1) diameter (inches) 4 x 2

(2) total depth (feet) 922

(3) static water level (feet) _____ below
top of ground. above

(4) casing BLACK WIRE MESH IRON 315
(material) (depth)

_____ if telescope see back.
(size)

(5) SCREEN BACK
(length) (depth to top)

_____ (size) _____ (material)

(6) pump 5 30
(HP) (yield gpm)

ELECTRIC
(type power)

(7) electric log yes
(yes or no)


Miss Geological Survey
(organization running log)

(8) how well bottom plugged Back
WASH VALVE

DRILLERS REMARKS:


description of formations encountered	from	to
Top Soil	0	25
Gravel	25	72
Sand	72	123
Clay	123	362
Shale & SAND streaks	365	473
SHALE	473	623
Sand	623	683
Shale	683	753
Sand	753	773
Shale	773	843
Clay	843	883
Sand	883	922

CODED

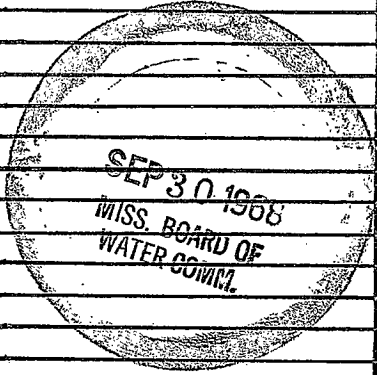

Design & Reconn on
9/24/68 by Dubonnelly

If well telescopes please sketch and show depths.

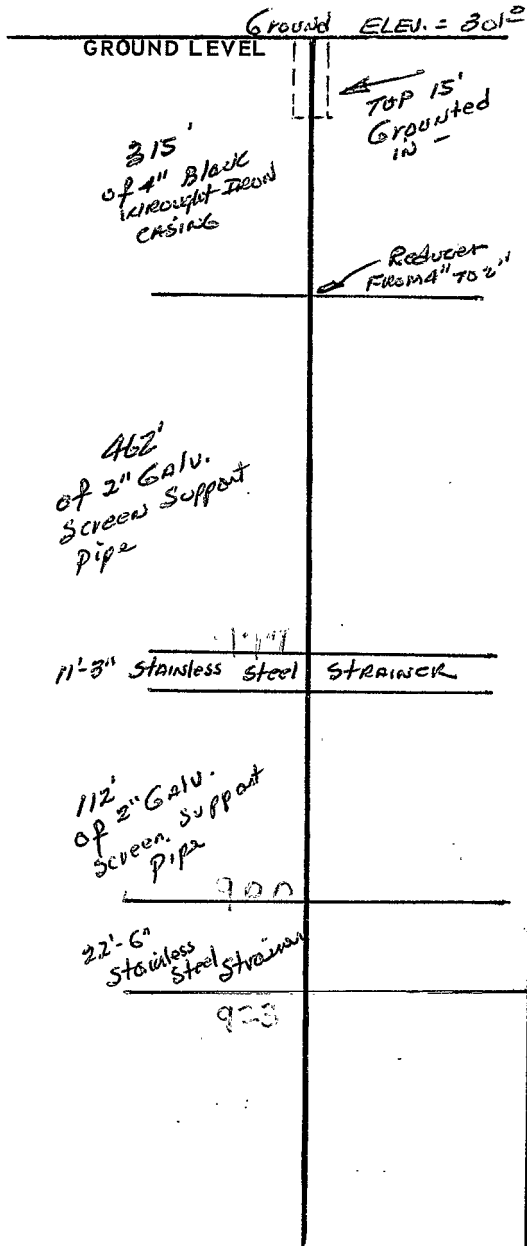

X			

SECTION 34

Please indicate well location X.

ADDITIONAL INFORMATION

Well located in EAST
LANE ON INTERSTATE
#50 AT Rest Area -
West side of Station
335792 - Serving
BATH Facilities & Drinking
Purposes.

If more than one screen, show locations of each on sketch.