

R22

CODED

5-22-64

WATER WELL DRILLERS LOG

Date: 5-22, 1964, Driller: James R. Lopez County Panola
 (Name)

(1) Owner of Land:	Description & Color of Materials Sand, Clay, Red Clay, Shell, etc.	Thick- ness Feet	Depth Feet
<u>Wain Caldwell</u> (Name) <u>Batesville, Miss.</u> (Address)	<u>Clay & gravel</u>	<u>0</u>	<u>48</u>
	<u>gravel & sand</u>	<u>15</u>	<u>100</u>
	<u>Sand</u>	<u>100</u>	<u>110</u>
	<u>Water sand</u>	<u>110</u>	<u>136</u>

(2) Location: 1/4, 1/4, Sec. 20 T. 9 R. 7
S. W.
3 miles South, of Batesville
 (distance) (direction) (Nearest Town)


(3) Topography: Hilly
 (Hilly) (Flat) (Level)

(4) Purpose of Well: Domestic
 (Domestic Irrigation
 Municipal, Industrial, Other)

Information upon completion of well:

- (1) Diameter 2 inches.
- (2) Total Depth 136' feet.
- (3) Water Level 80 feet below top of ground.
- (4) Cased to 126', Size 2"
- (5) Screen: Size 1/4, Length 6'
- (6) Were any formations sealed against pollution?
 yes, no.

If YES depth of formation _____
 Why _____
 Drillers Remarks: _____

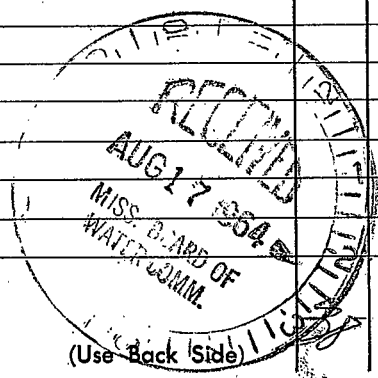

Well No.

