

R 23

CODED

10-8-64

WATER WELL DRILLERS LOG

Date: 10-8, 1964, Driller: Frank ^{Wife} Ziegler County Panola
(Name)

(1) Owner of Land: A. J. Harmon
(Name)
Batesville
(Address)

Description & Color of Materials
Sand, Clay, Red Clay, Shell, etc.

Thick-
ness
Feet

Depth
Feet

Clay
Clay gravel
gravel
Sand-water
0 20
20 50
50 55
55 80

(2) Location: 1/4, 1/4, Sec. 9 T 9 R 7
1 miles east of Batesville
(distance) (direction) (Nearest Town)

(3) Topography: Hilly
(Hilly) (Flat) (Level)

(4) Purpose of Well: Farm
(Domestic Irrigation
Municipal, Industrial, Other)

Information upon completion of well:

(1) Diameter 4" inches.

(2) Total Depth 80' feet.

(3) Water Level 30 feet below top of ground.

(4) Cased to Top, Size 4"


(5) Screen: Size 4", Length 4ft

(6) Were any formations sealed against pollution?
yes, no.

If YES depth of formation

Why

Drillers Remarks:

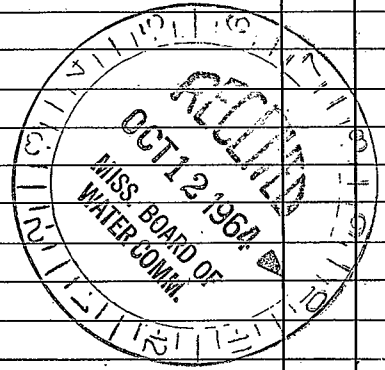

(Use Back Side)

9

Well No.

[The page contains extremely faint and illegible text, likely bleed-through from the reverse side of the document. No specific content can be transcribed.]