

PANOLA

MISSISSIPPI BOARD OF WATER COMMISSIONERS

R 24

11-13-64

WATER WELL DRILLERS LOG

CODED

Date: 11-13, 19 64, Driller: James R Lyle County Panola

(Name)

(1) Owner of Land: James Jones

(Name)

Batesville

(Address)

(2) Location: 1/4, 1/4, Sec 30 T 9 N R 7 S W

6 miles S.W. of Batesville

(distance)

(direction)

(Nearest Town)

(3) Topography: Hilly

(Hilly)

(Flat)

(Level)

(4) Purpose of Well: Domestic

(Domestic Irrigation, Municipal, Industrial, Other)

Description & Color of Materials
Sand, Clay, Red Clay, Shell, etc.

Thick-
ness
Feet

Depth
Feet

Clay	0	52
Clay & gravel	52	80
Gravel	80	100
Sand & gravel	100	115
Water Sand	115	151

Information upon completion of well:

(1) Diameter 4 inches.

(2) Total Depth 151 feet.

(3) Water Level 50 feet below top of ground.

(4) Cased to top, Size 4"

(5) Screen: Size 4", Length 6'


(6) Were any formations sealed against pollution?

yes, no.

If YES depth of formation

Why

Drillers Remarks:

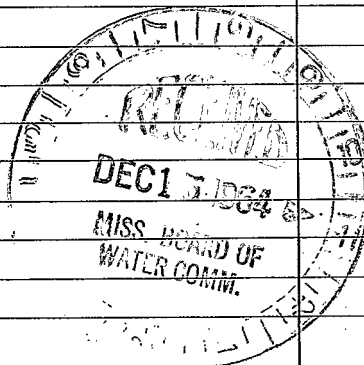

(Use Back Side)

Well No.

