

MISSISSIPPI BOARD OF WATER COMMISSIONERS

WATER WELL DRILLERS LOG

CODED

Date: 9.27, 1965, Driller: James G. Lipe Franklin County Panola  
(Name)

(1) Owner of Land: A. I. Morris  
(Name)  
Courtland, Miss.  
(Address)

(2) Location: 36 T 9 R 7  
5 miles east of Batesville  
(distance) (direction) (Nearest Town)

(3) Topography: Hilly  
(Hilly) (Flat) (Level)


(4) Purpose of Well: Domestic  
(Domestic Irrigation  
Municipal, Industrial, Other)

Description & Color of Materials Sand, Clay, Red Clay, Shell, etc.	Thick- ness Feet	Depth Feet
Top soil	0	20
Sand	20	40
Sand and gravel	40	80
Pea gravel	80	106

Information upon completion of well:

- (1) Diameter 4 inches.
- (2) Total Depth 106 feet.
- (3) Water Level 90 feet below top of ground.
- (4) Cased to 100, Size 4,
- (5) Screen: Size 4, Length 6.
- (6) Were any formations sealed against pollution?  
\_\_\_\_\_ yes, \_\_\_\_\_ no.

If YES depth of formation \_\_\_\_\_  
Why \_\_\_\_\_  
Drillers Remarks: \_\_\_\_\_

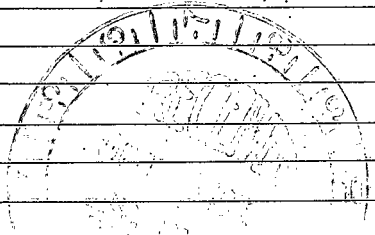

(Use Back Side)

Well No.

