

R 27  
12-18-66

James Ray Lipe  
WATER WELL DRILLERS LOG

CODED

Date: 12-18, 1966, Driller: Frank Hylton County Panola  
(Name)

(1) Owner of Land: Mr. J. D. Smith  
(Name)  
Batesville  
(Address)

(2) Location: 1/4, 1/4, Sec. 2797  
SW  
3 miles east of Batesville  
(distance) (direction) (Nearest Town)

(3) Topography: Hilly  
(Hilly) (Flat) (Level)

(4) Purpose of Well: Dom.  
(Domestic Irrigation  
Municipal, Industrial, Other)

Description & Color of Materials Sand, Clay, Red Clay, Shell, etc.	Thick- ness Feet	Depth Feet
<u>Clay</u>	<u>0</u>	<u>65</u>
<u>Gravel &amp; Sand</u>	<u>65</u>	<u>98</u>
<u>Gravel</u>	<u>98</u>	<u>125</u>
<u>sub sand</u>	<u>125</u>	<u>162</u>

Information upon completion of well:

(1) Diameter 4" inches.

(2) Total Depth 162 feet.

(3) Water Level 69 feet below top of ground.

(4) Cased to 162, Size 4"

(5) Screen: Size 4", Length 4'


(6) Were any formations sealed against pollution?  
\_\_\_\_\_ yes, \_\_\_\_\_ no.

CODED

If YES depth of formation \_\_\_\_\_

Why \_\_\_\_\_

Drillers Remarks: \_\_\_\_\_

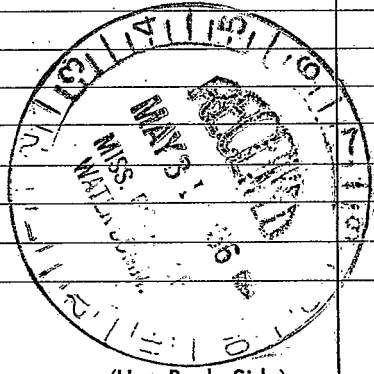

(Use Back Side)

Well No.

100-100000