

Panola
R28
12-68

MISSISSIPPI
 BOARD OF WATER COMMISSIONERS
 416 North State Street
 Jackson, Mississippi 39201

CODED

WATER WELL DRILLERS LOG

James R. Iipe Panola

date well completed 19

firm name


county well located

LANDOWNER: <u>Standard oil Co.</u>	description of formations encountered	from	to
<u>Batesville</u>	<u>Clay</u>	<u>0</u>	<u>20</u>
<u>Miss.</u>	<u>Sand and clay</u>	<u>20</u>	<u>40</u>
(mailing address)	<u>Gravel</u>	<u>40</u>	<u>60</u>
	<u>"</u>	<u>60</u>	<u>80</u>
	<u>Gravel and sand</u>	<u>80</u>	<u>90</u>
	<u>Sand</u>	<u>90</u>	<u>100</u>
	<u>Good sand</u>	<u>100</u>	<u>120</u>
	<u>" "</u>	<u>120</u>	<u>130</u>
	<u>Sand and clay</u>	<u>130</u>	<u>140</u>
	<u>Good sand</u>	<u>140</u>	<u>160</u>
	<u>" "</u>	<u>160</u>	<u>180</u>
WELL LOCATION: sec. <u>9</u> T. <u>9</u> N. R. <u>3</u> E <u>1</u> miles <u>East</u> of <u>Batesville</u> (distance) (direction) (nearest town)			
WELL PURPOSE: (home, irrigation, municipal, industrial)			
WELL COMPLETION DATA:			
(1) diameter (inches) <u>4"</u>			
(2) total depth (feet) <u>180</u>			
(3) static water level (feet) <u>120</u> below top of ground.			
(4) casing <u>Plastic</u> , <u>170</u> (material) (depth)			
(size) If telescope see back.			
(5) screen <u>10</u> , <u>170</u> (length) (depth to top)			
<u>4"</u> , <u>Plastic</u> (size) (material)			
(6) pump <u>1/2</u> , <u>30</u> (HP) (yield gpm)			
<u>Elec.</u> (type power)			
(7) electric log <u>no</u> (yes or no)			
(organization running log)			
(8) how well bottom plugged <u>4"</u> <u>Plastic</u> <u>plug</u>			
DRILLERS REMARKS:			

MISS. ED. BY
 WATER COM.

If well telescopes please sketch and show depths.

GROUND LEVEL

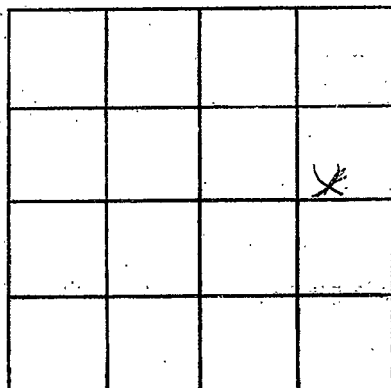

SECTION 9

Please indicate well location X.

ADDITIONAL INFORMATION

If more than one screen,
show locations of each on sketch.