

CODED

MISSISSIPPI  
BOARD OF WATER COMMISSIONERS  
416 North State Street  
Jackson, Mississippi 39201

WATER WELL DRILLERS LOG

Panola  
R 31  
3-26-70

MAR 26 1970 LIPE WELL CO. PANOLA  
date well completed firm name county well located

LANDOWNER:  
BUD LEIGH  
COURTLAND, MISS  
(mailing address)

description of formations encountered	from	to
top soft sand	0	20
sand & gravel	20	40
sand	40	60
sand	60	80
sand	80	100
sand	100	120
sand	120	140

WELL LOCATION:  
sec. 29 T 29 S R 31 W  
3 1/2 miles NW of Courtland  
(distance) (direction) (nearest town)

WELL PURPOSE: home  
(home, irrigation, municipal, industrial)

WELL COMPLETION DATA:

(1) diameter (inches) 4"

(2) total depth (feet) 138

(3) static water level (feet) 80 below top of ground.

(4) casing PVC, 130 (material) (depth)  
4" (size) If telescope see back.

(5) screen 8" 130 (length) (depth to top)  
4" PVC (size) (material)

(6) pump 1/2 10 (HP) (yield gpm)  
elec (type power)

(7) electric log no (yes or no)  
V  
(organization running log)

(8) how well bottom plugged PVC CAP

CODED


APR 20 1970

MISS. BD. OF  
WATER COM.

DRILLERS REMARKS:

If well telescopes please sketch and show depths.

GROUND LEVEL

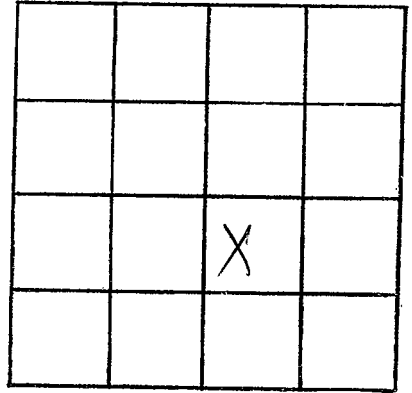

SECTION 29

Please indicate well location X.

ADDITIONAL INFORMATION

Lined area for additional information.

If more than one screen, show locations of each on sketch.