

PA NO 1A
R 32
7-15-70

MISSISSIPPI
BOARD OF WATER COMMISSIONERS
416 North State Street
Jackson, Mississippi 39201

CODED

WATER WELL DRILLERS LOG

July 15 1970 Lippe Well Co. Panola
date/well completed firm name county well located

LANDOWNER:
Roy McCollar
Eureka, Miss
(mailing address)

description of formations encountered	from	to
Clay	0	20
"	20	40
Gravel	40	60
"	60	80
Clay	80	100
Sand and clay	100	120
Sand	120	140
Sand	140	156

WELL LOCATION:
sec. 16 T. 9 N. R. 7 E.
2 miles SE of Batesville
(distance) (direction) (nearest town)

WELL PURPOSE: home
(home, irrigation, municipal, industrial)

- WELL COMPLETION DATA:
- (1) diameter (inches) 4
 - (2) total depth (feet) 156
 - (3) static water level (feet) 80 below top of ground.
 - (4) casing PVC 146 (material) (depth)
4 (size) if telescope see back.
 - (5) screen 12 146 (length) (depth to top)
4 PVC (size) (material)
 - (6) pump 3/4 15 (HP) (yield gpm)
ELEC (type power)
 - (7) electric log no (yes or no)
no (organization running log)
 - (8) how well bottom plugged PVC
PVC

CODED


AUG 24 1970

MISS. RD. 05
WATER COMMISSION

DRILLERS REMARKS:

If well telescopes please sketch and show depths.

GROUND LEVEL

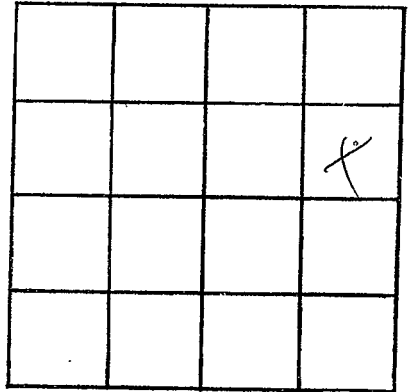

SECTION 16

Please indicate well location X.

ADDITIONAL INFORMATION

If more than one screen, show locations of each on sketch.