

PANOLA
 R33
 2-20-71

MISSISSIPPI
 BOARD OF WATER COMMISSIONERS
 416 North State Street
 Jackson, Mississippi 39201

CODED

WATER WELL DRILLERS LOG

Feb. 20 19 71 *B. Cain*
 date well completed firm name county well located

LANDOWNER: *CHROME PLANT*

description of formations encountered

from to

<i>Buck shot clay</i>	<i>0</i>	<i>10</i>
<i>SAND and GRAVEL</i>	<i>10</i>	<i>80</i>
<i>WATER SAND</i>	<i>80</i>	<i>140</i>

(mailing address)

WELL LOCATION:

sec *16* T *9* N R *7* E
 miles of (distance) (direction) (nearest town)

WELL PURPOSE: *PLANT*
 (home, irrigation, municipal, industrial)

WELL COMPLETION DATA:

- (1) diameter (inches) *4"*
- (2) total depth (feet) *140'*
- (3) static water level (feet) _____ below above top of ground.
- (4) casing *PLASTIC, 130'*
 (material) (depth)
4"
 (size) if telescope see back.
- (5) screen *10'*, *140'*
 (length) (depth to top)
4, *GRAVEL/PACK*
 (size) (material)
- (6) pump _____ (HP) _____ (yield gpm)
220
 (type power)
- (7) electric log _____ (yes or no)

CODED

(8) how well bottom plugged *mask Bottom*
 (organization running log)


APR - 6 1971

DRILLERS REMARKS:

MISS. Bd. of
 WATER COMM.

If well telescopes please sketch and show depths.

GROUND LEVEL

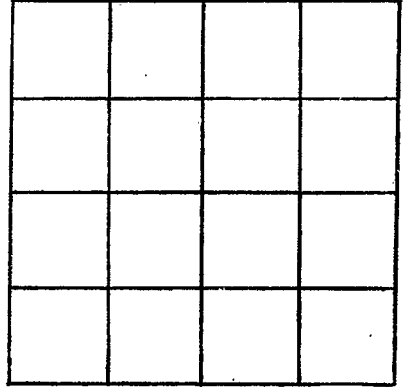

SECTION _____

Please indicate well location X.

ADDITIONAL INFORMATION

If more than one screen, show locations of each on sketch.