

PANOLA
R 34
2-4-71

MISSISSIPPI
 BOARD OF WATER COMMISSIONERS
 416 North State Street
 Jackson, Mississippi 39201

CODED

WATER WELL DRILLERS LOG

2-4 1971 James R. Lipe Panola
 date well completed firm name county well located

LANDOWNER: James T. Taylor
Courtland Miss.
 (mailing address)

description of formations encountered	from	to
<u>Clay</u>	<u>0</u>	<u>20</u>
<u>"</u>	<u>20</u>	<u>40</u>
<u>Sand</u>	<u>40</u>	<u>60</u>
<u>sand and gravel</u>	<u>60</u>	<u>80</u>
<u>Gravel</u>	<u>80</u>	<u>100</u>
<u>"</u>	<u>100</u>	<u>120</u>
<u>Sand</u>	<u>120</u>	<u>155</u>

WELL LOCATION:
 sec. 29 T 9 N R 7 E
3 miles West of Courtland
 (distance) (direction) (nearest town)

WELL PURPOSE: Home
 (home, irrigation, municipal, industrial)

- WELL COMPLETION DATA:
- (1) diameter (inches) 4"
 - (2) total depth (feet) 155
 - (3) static water level (feet) 80 below above top of ground.
 - (4) casing PVC 145
 (material) (depth)
4"
 (size) if telescope see back.
 - (5) screen 10 145
 (length) (depth to top)
4" PVC
 (size) (material)
 - (6) pump 3/4 10
 (HP) (yield gpm)
Elec.
 (type power)
 - (7) electric log no
 (yes or no)
no
 (organization running log)
 - (8) how well bottom plugged PVC
plug

CODED


MAY 14 1971

DRILLERS REMARKS:

MISS. BD. OF
 WATER COMMISSIONERS

If well telescopes please sketch and show depths.

GROUND LEVEL

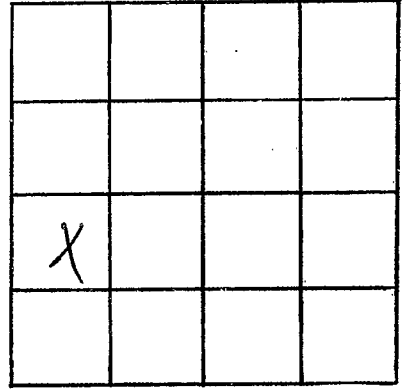

SECTION 29

Please indicate well location X.

ADDITIONAL INFORMATION

A series of horizontal lines for writing additional information.

If more than one screen, show locations of each on sketch.