

PANOLA
R 35
3-19-71

MISSISSIPPI
BOARD OF WATER COMMISSIONERS
416 North State Street
Jackson, Mississippi 39201

CODED

WATER WELL DRILLERS LOG

3-19 1971 James R. Lipe Panola
date well completed firm name county well located

LANDOWNER: Cecil Morris
Courtland Miss.
(mailing address)

description of formations encountered	from	to
	Clay	0
cl	20	40
gravel	40	60
cl	60	80
sand	80	100
cl	100	133

WELL LOCATION:
sec. 23 T 9 N R 7 E
5 miles East of Batesville
(distance) (direction) (nearest town)

WELL PURPOSE: Home
(home, irrigation, municipal, industrial)

- WELL COMPLETION DATA:
- (1) diameter (inches) 4"
 - (2) total depth (feet) 133
 - (3) static water level (feet) 50 below above top of ground.
 - (4) casing PVC 123 (material) (depth)
4" (size) If telescope see back.
 - (5) screen 10 123 (length) (depth to top)
4" PVC (size) (material)
 - (6) pump 3/4 10 (HP) (yield gpm)
Elec. (type power)
 - (7) electric log no (yes or no)
no (organization running log)
 - (8) how well bottom plugged PVC Plug

CODED


MAY 14 1971

DRILLERS REMARKS:

MISS. BD. OF
WATER COMM.

If well telescopes please sketch and show depths.

GROUND LEVEL

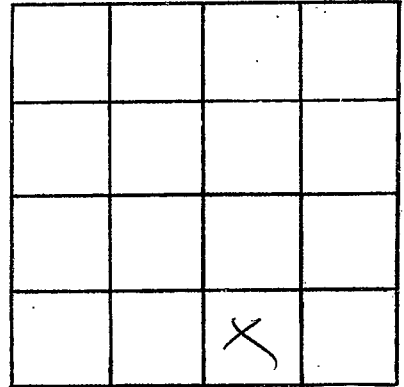

SECTION 23

Please indicate well location X.

ADDITIONAL INFORMATION

If more than one screen,
show locations of each on sketch.